


Sec. 24, T. 36 S., R. 4 W. W. M.

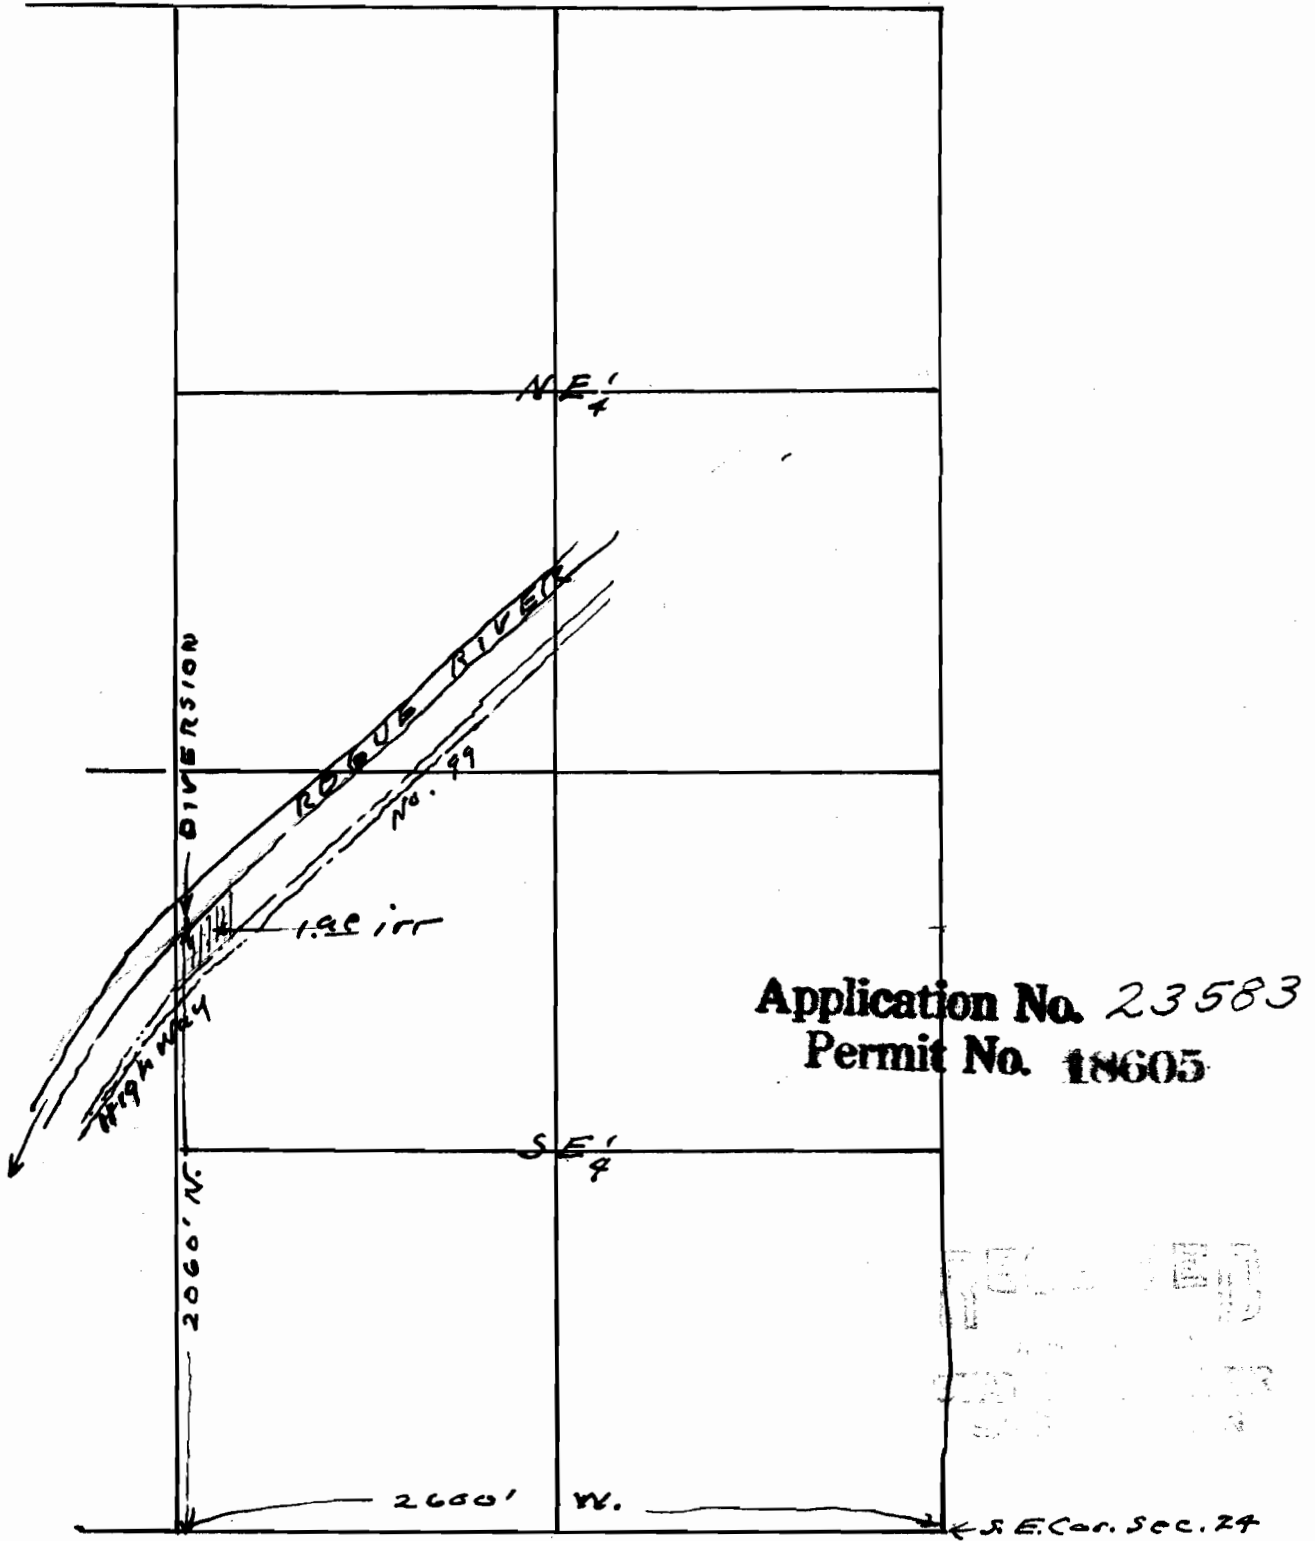

Map To accompany application of Hills Flycaster Auto Court, Sue K Shoemaker Mgr. for use of water from Roque River for irrigation.

This office 12/20/45

23583

15-600