


T. 35 S., R. 4 W., W.M.

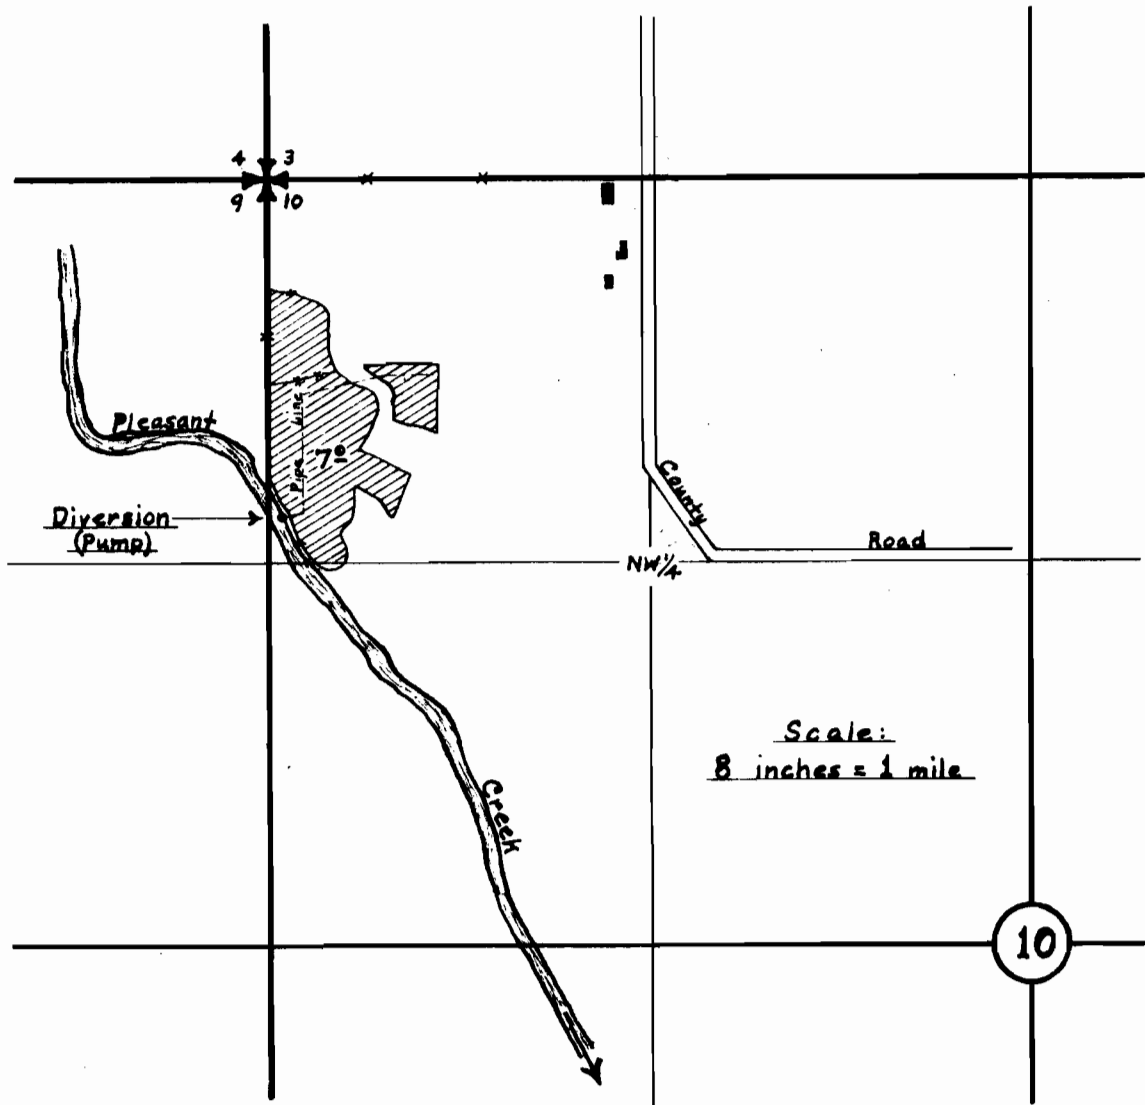

FINAL PROOF SURVEY

UNDER

Application No. 23590 Permit No. 18609
IN NAME OF

George H. Johnston

Surveyed March 27, 1958, by David C. Hendrix, W.M.