


T. 36 S., R. 5 W. W.M.
Scale 400' = 1" April 1949

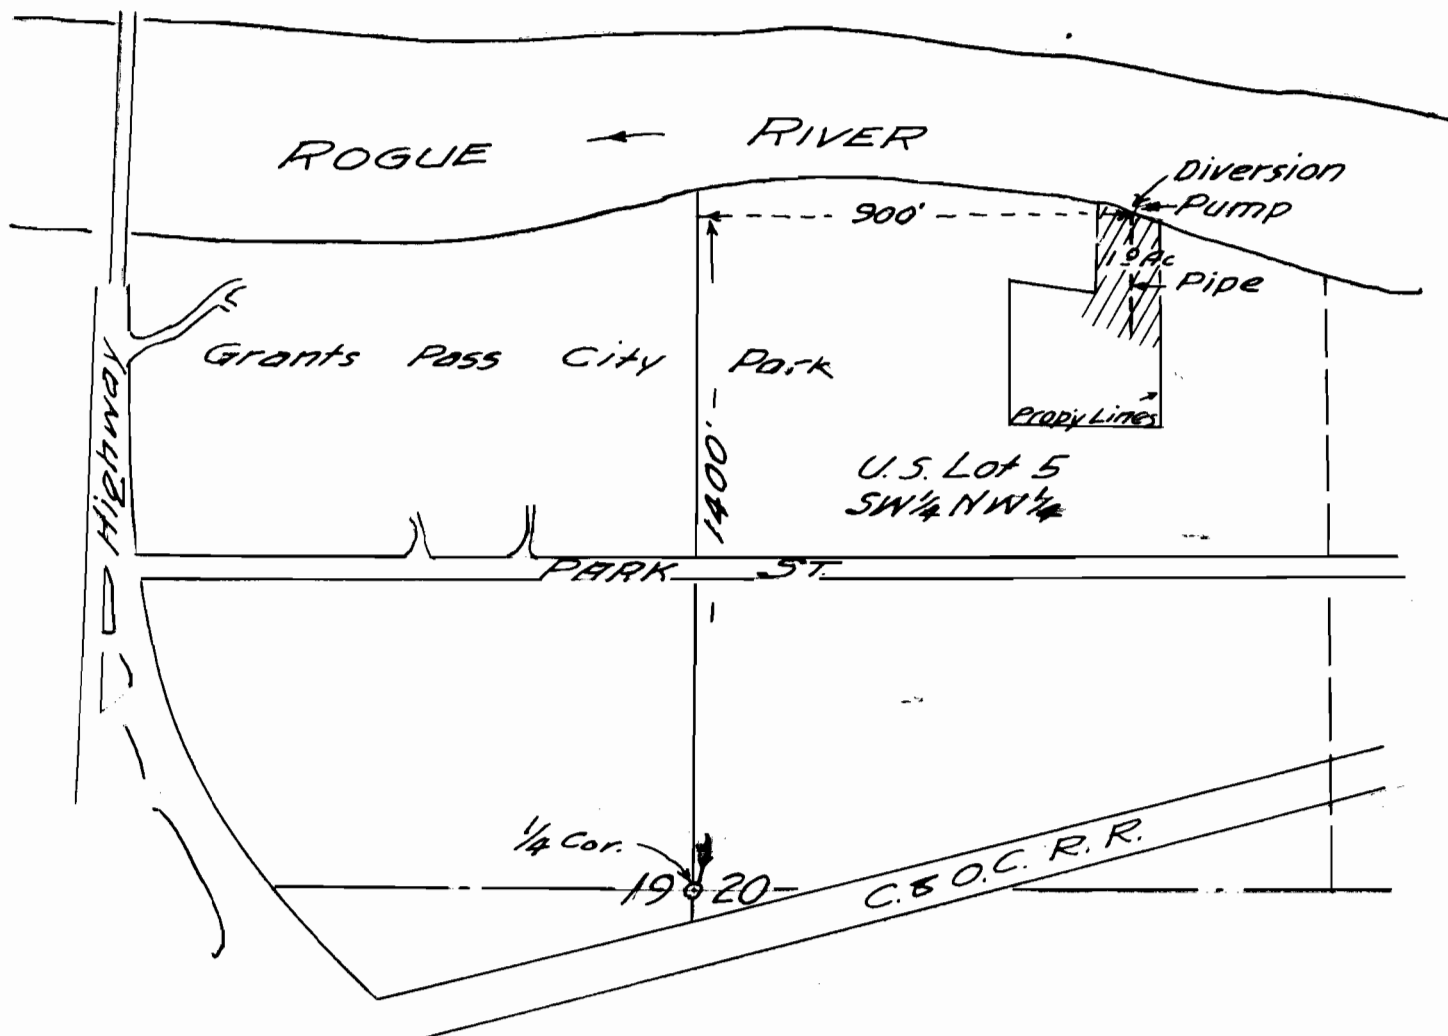

J. Vinton Scott

Application No. 23715
Permit No. 15724

RECEIVED

23715

15-60B