


Sec. 34, T. 36 S., R. 4 W. W.M.

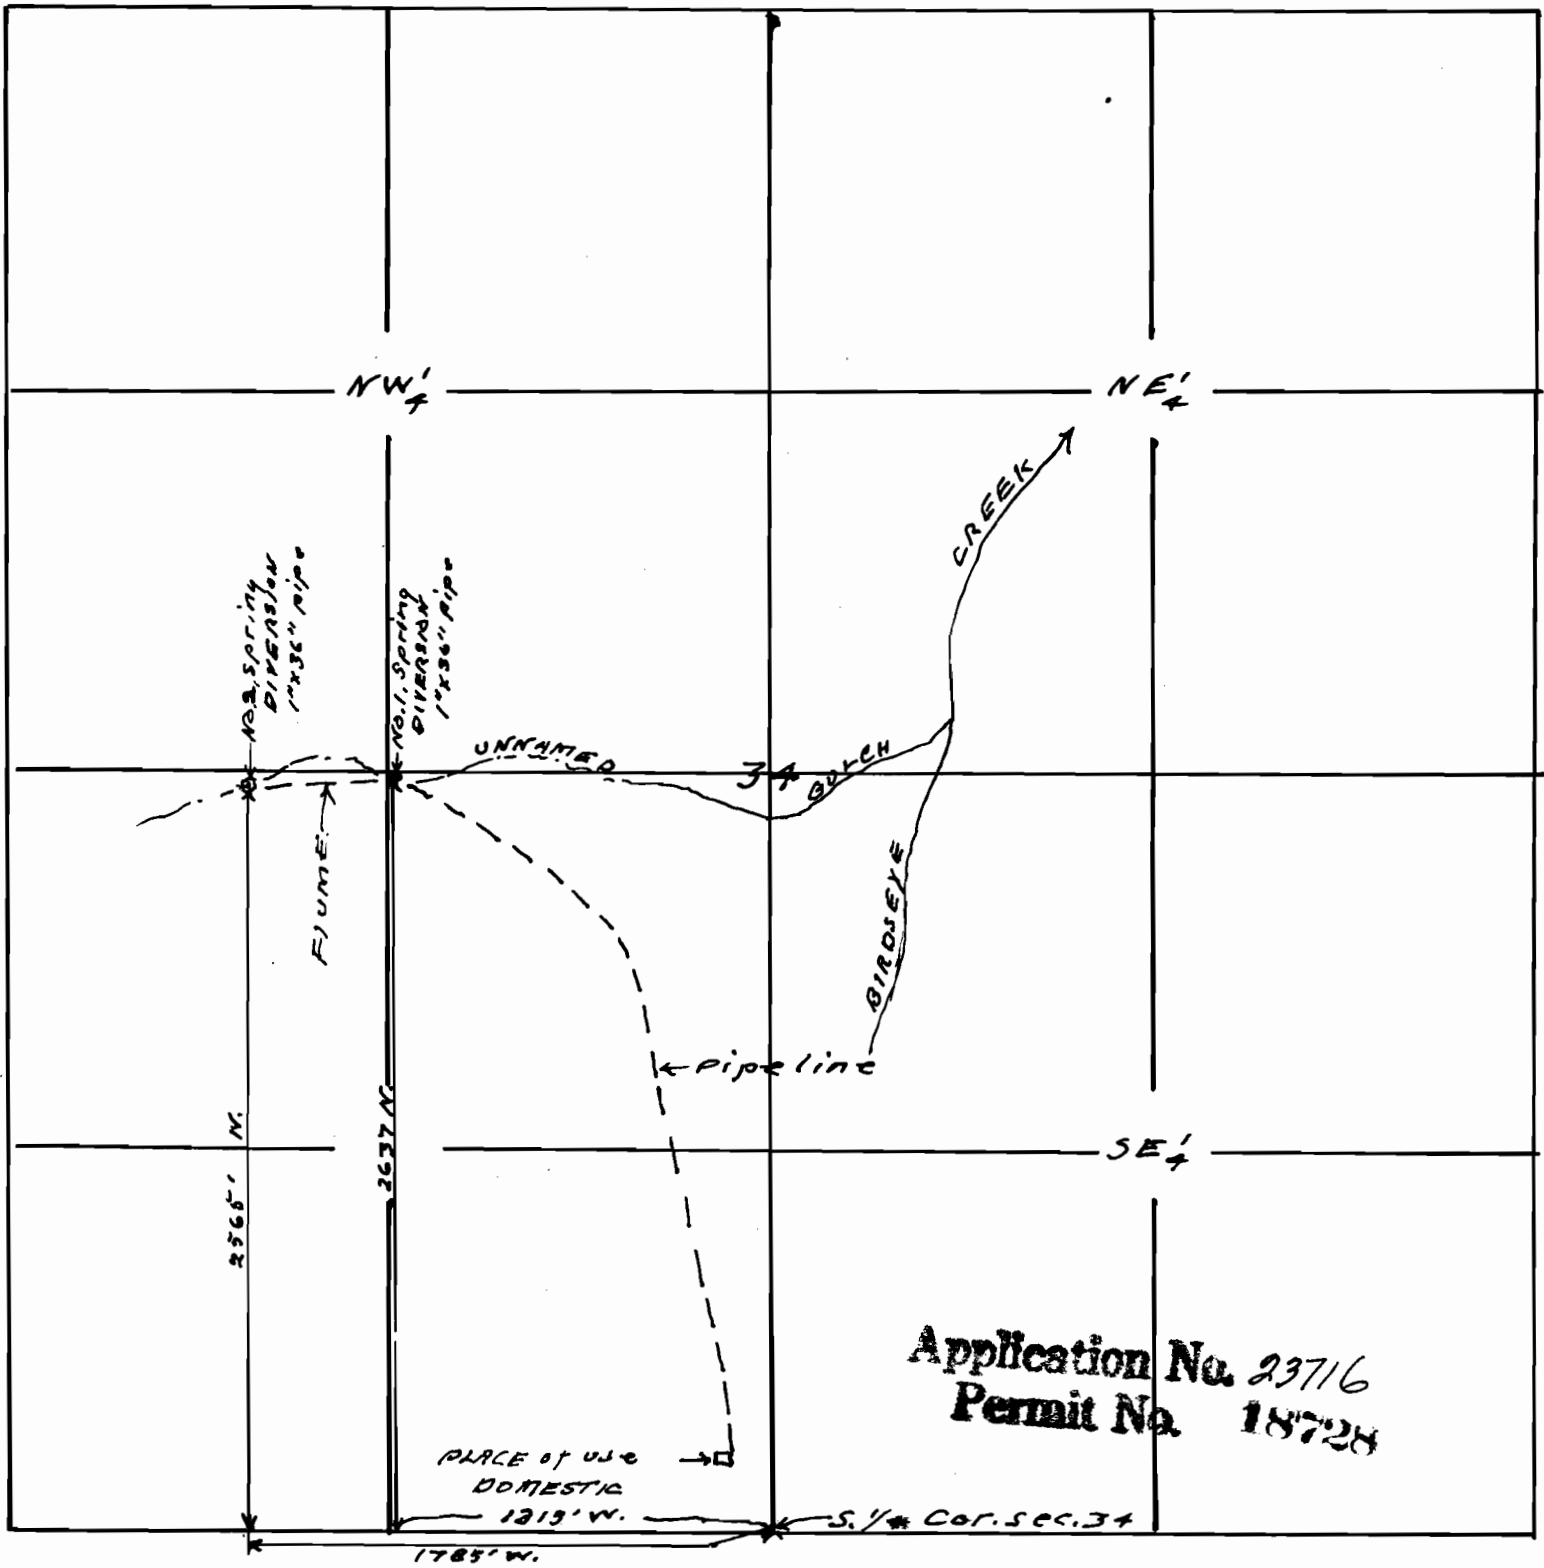

Map to accompany application of
Ora Card Lanham for use of springs
in unnamed gulch for domestic use

This office 4/13/49 *[Signature]*

23716

15-78 G