


SEC. 15, T. 34S., R. 1 W.W.M.

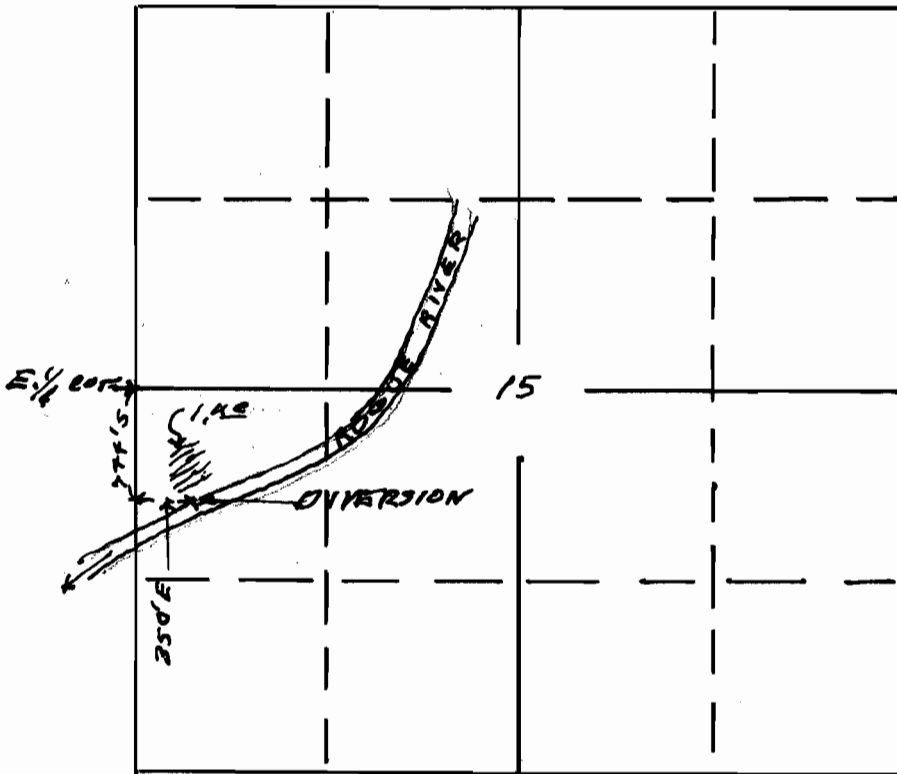

Map to accompany application of
Frank J. Cook for use of water
from Rogue River for irrigation

This office 4/26/49 *[Signature]*

Application No. 23749
Permit No. 18749