


Sec. 20, T. 33 S., R. 1 W., W.M.

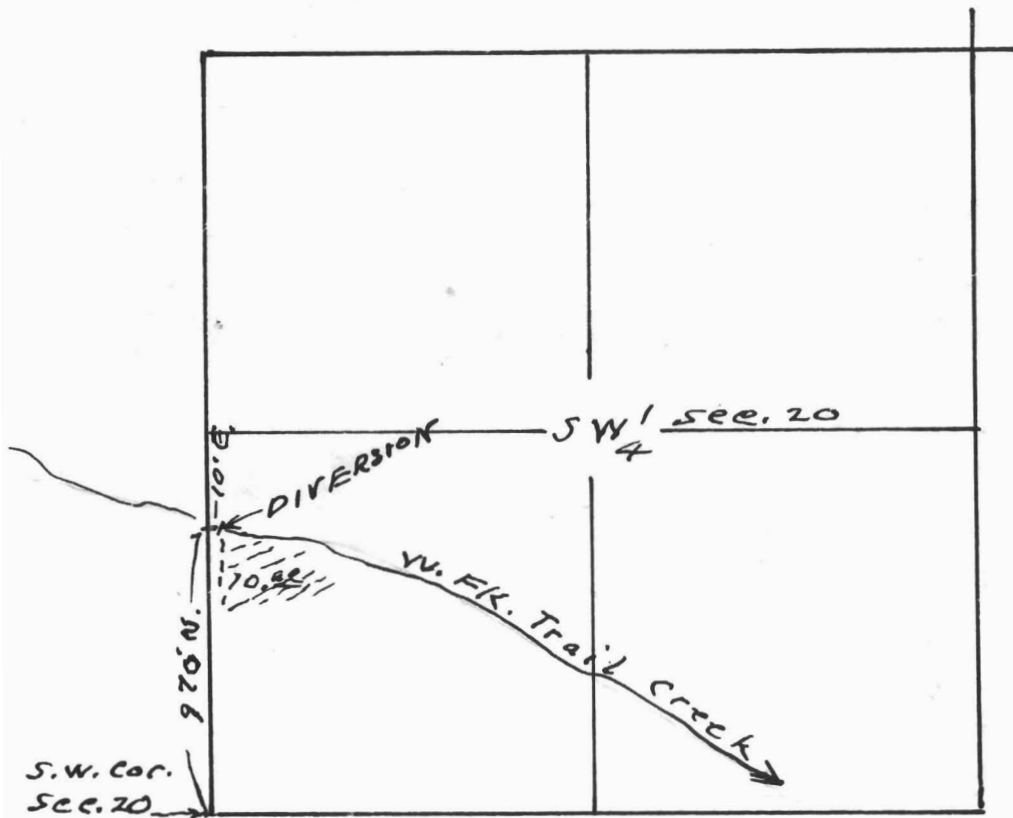

Map to accompany application
of W. H. Cushman for use of water
from W. Fk. Trail Creek for
irrigation purposes.

This office 6/20/49 *Smith*

Application No. 23860
Permit No. 18792

RECEIVED
JUN 21 1949
STATE ENGINEER
SALEM, OREGON