


Sec. 4, T. 38 S., R. 3 W. W. M.

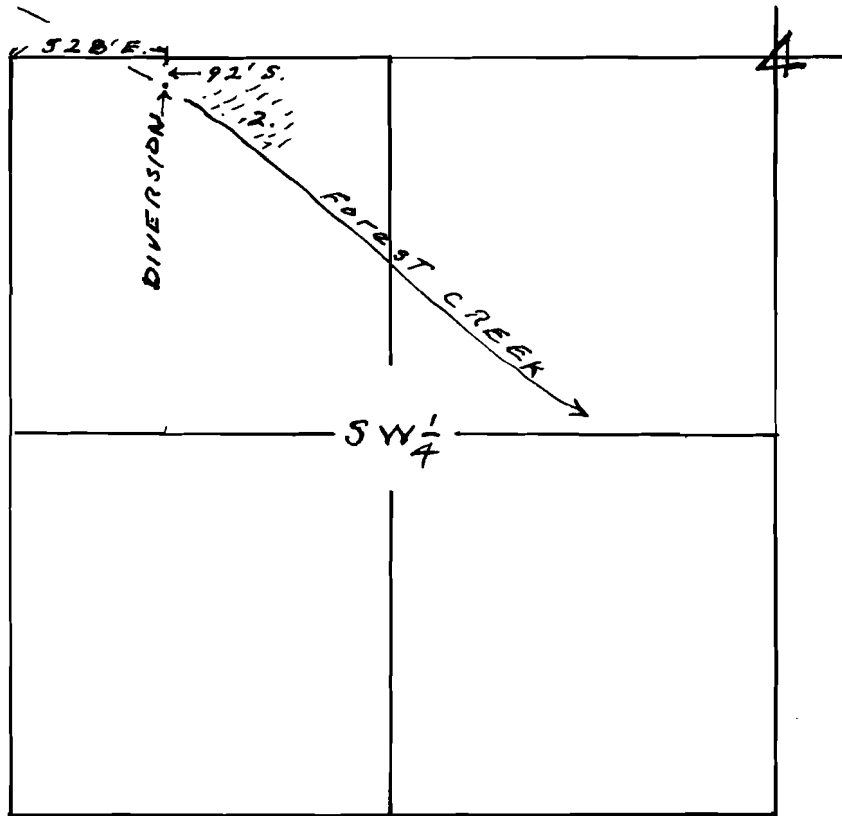

Map to accompany application of
Clayton B. Goodnight for use of
water from Forest Creek for
irrigation purposes.

This office 7/8/49 *[Signature]*

Application No. 23903
Permit No. 18833