


T.36S. R.1W.W.M.

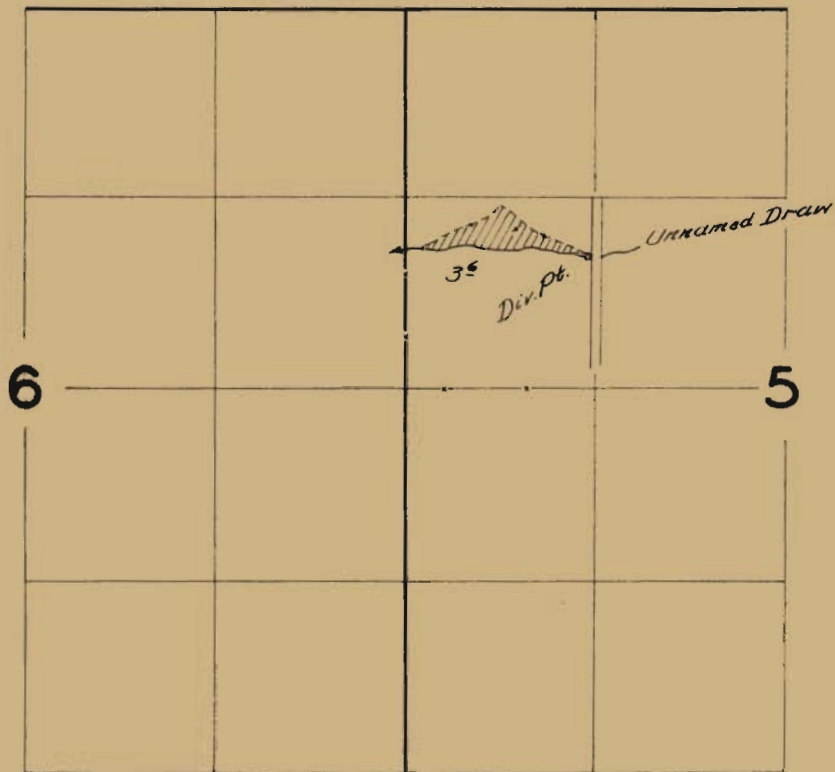

FINAL PROOF SURVEY
UNDER

Application No. 23973 Permit No. 18918 C&T. 26706
IN NAME OF

C. E. Smith

Surveyed *May 11* 1959, by *C. D. Bartels*