


Sec's 19, 24 T. 39. S, R. 12 E. W.M.

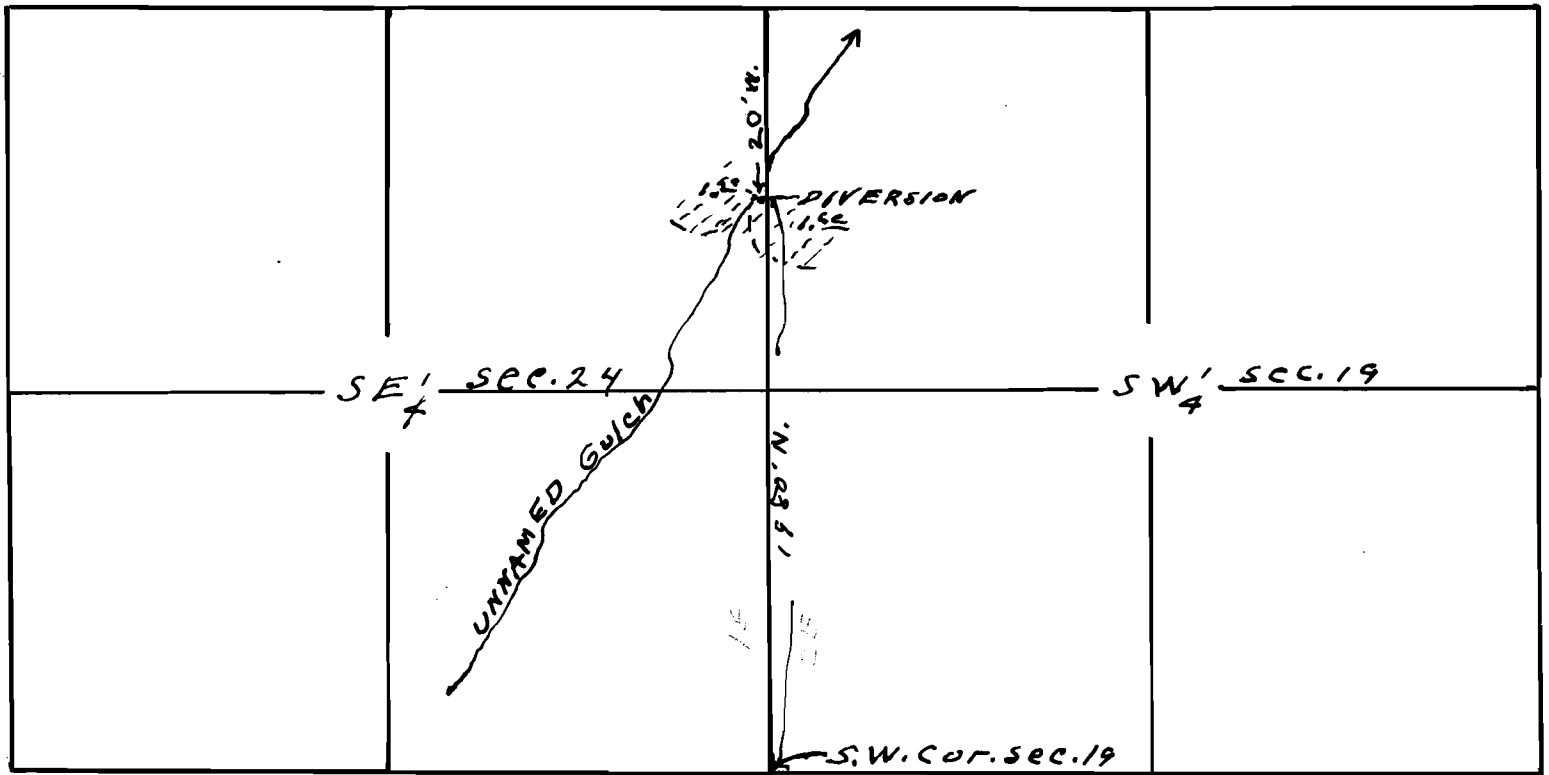

Map To accompany application of
Kenneth Desrude for use of water
from unnamed gulch for irrigation

This office 9/20/49 ~~at~~ *initials*

Application No. 23989
Permit No. 18927

23989

15-24