


T 32 S., R's 4 and 5 W., W. M.

Scale 4" = 1 Mile

Oct. 1949

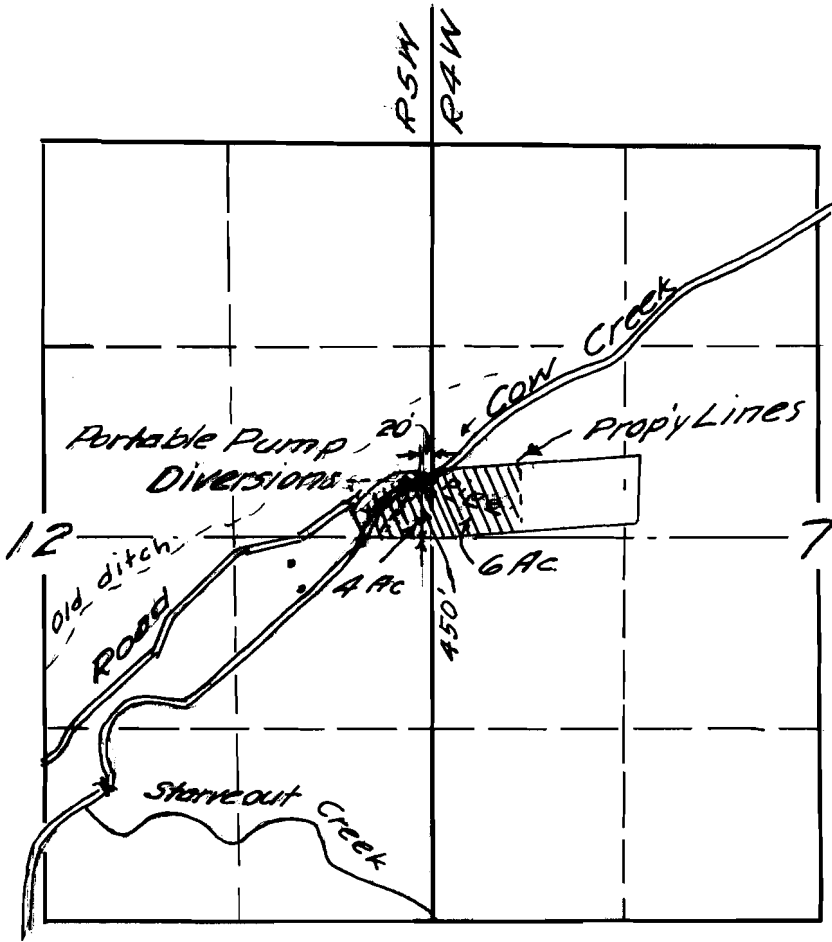


Julius Strobl, Jr.

Application No. 24225
Permit No. 19033

T 32 S, R's 4 and 5 W. W. M.

Scale 4" = 1 Mile

Oct. 1949

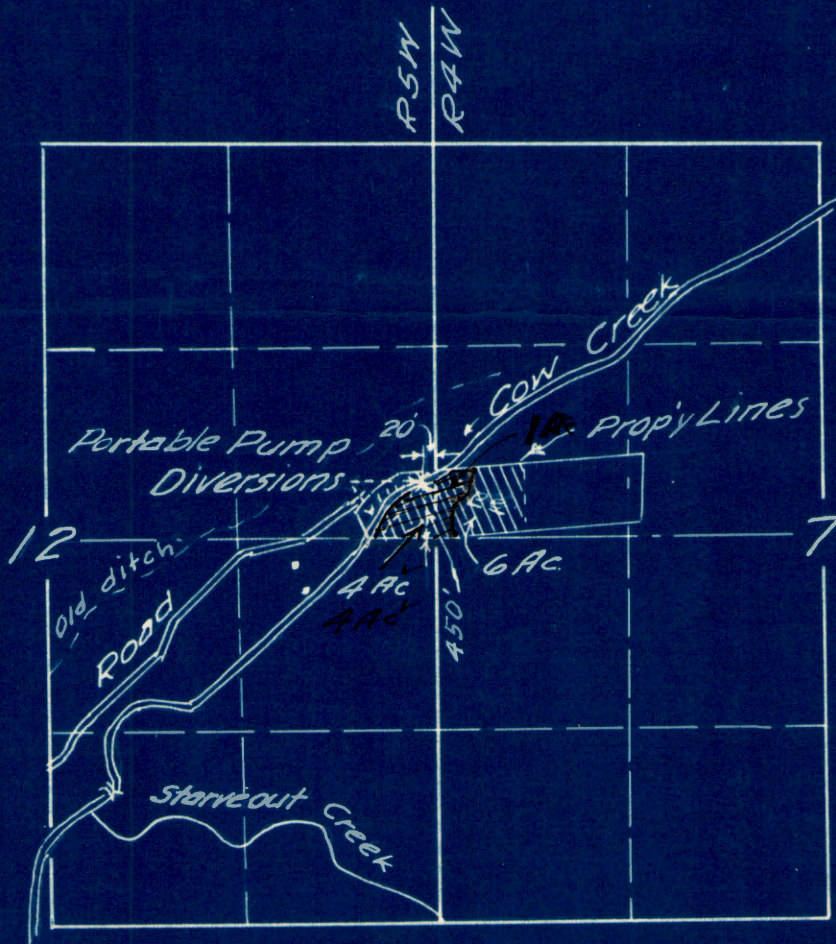

Julius Strobl, Jr.

Application No. 24225
Permit No. 19033