


T. 35 S., R. 4 W., W. M.

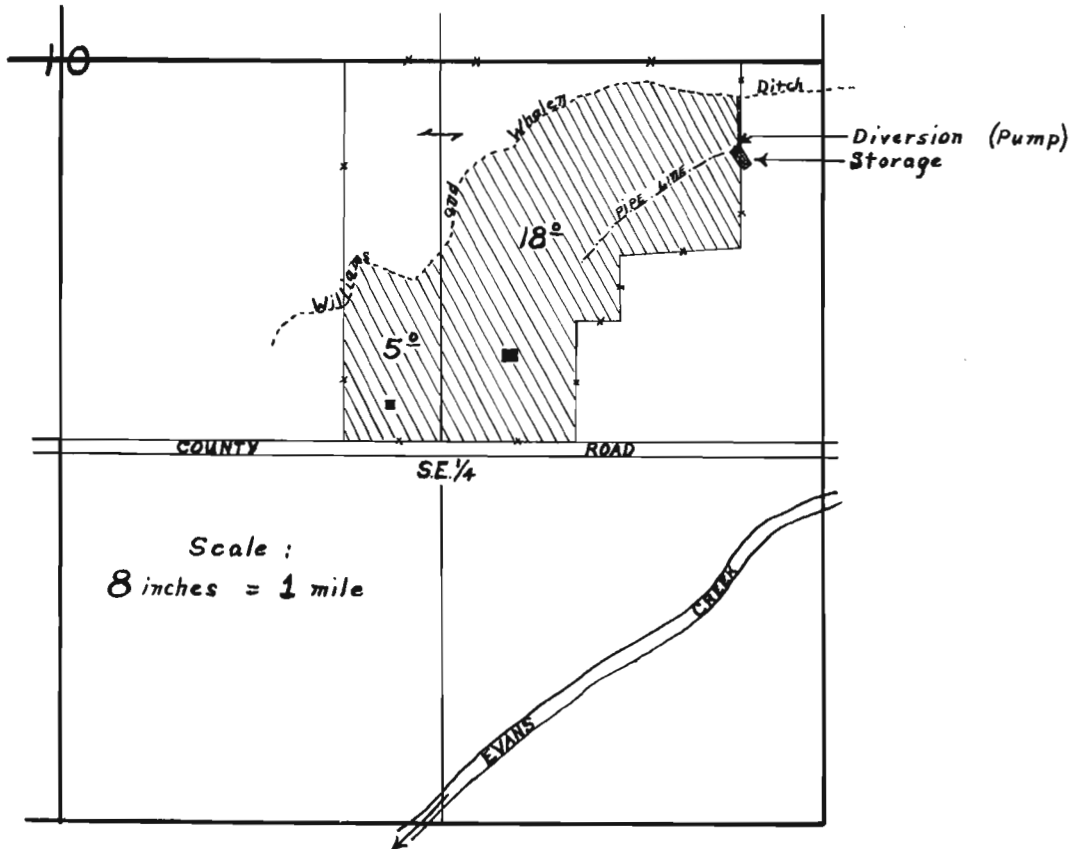

Map to accompany final proofs of
Ralph W. Badcock, for use of water
from Storage for Supplemental
Irrigation purposes.


Application Nos. 24298
R-21921
Permit Nos. 19037
R-849

Plane table survey - Made April 8, 1955

David C. Hendrix, Watermaster

RECEIVED
MAY 13 1955
STATE ENGINEER
SALEM, OREGON

SEC. 10, T. 35 S., R. 4 W. W. M.

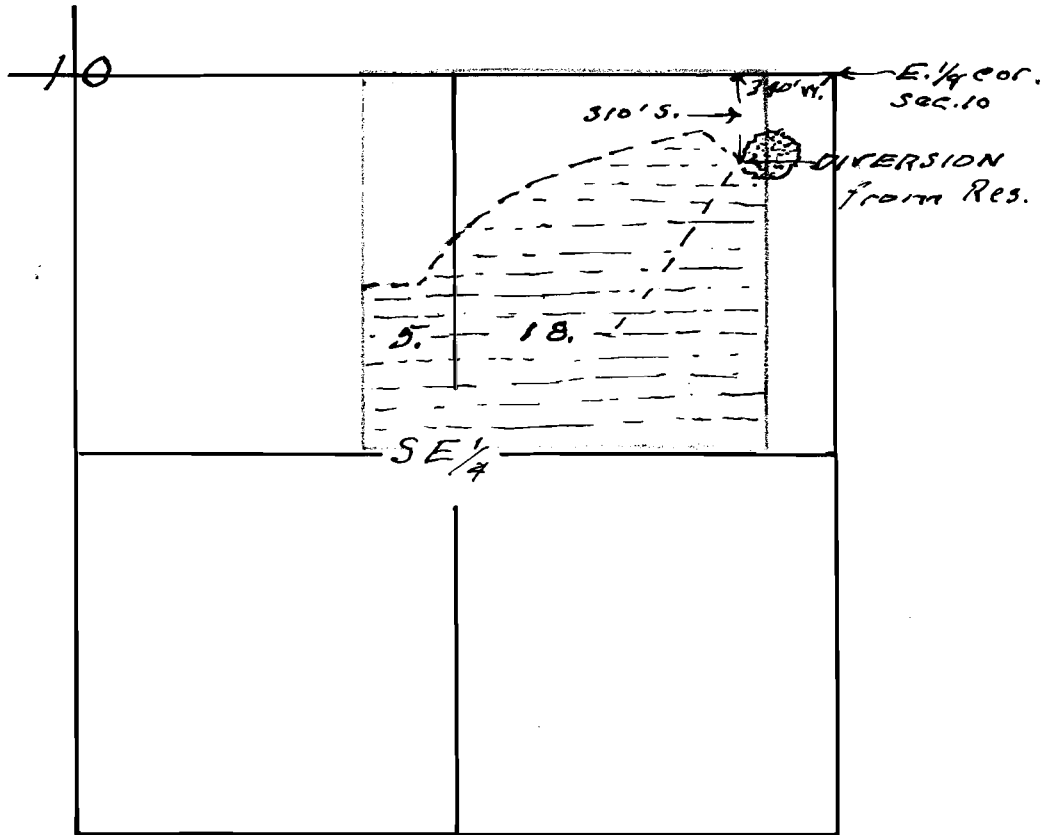

Map to accompany application of
Ralph W. Badcock for use of
water from storage under
Permit No R-899 for supplemental
irrigation.

Application No. 24238
Permit No. 19037

This office 10/25/49 *W. Smith*