


Sec. 23, T. 38 S., R. 4 W. W. M.

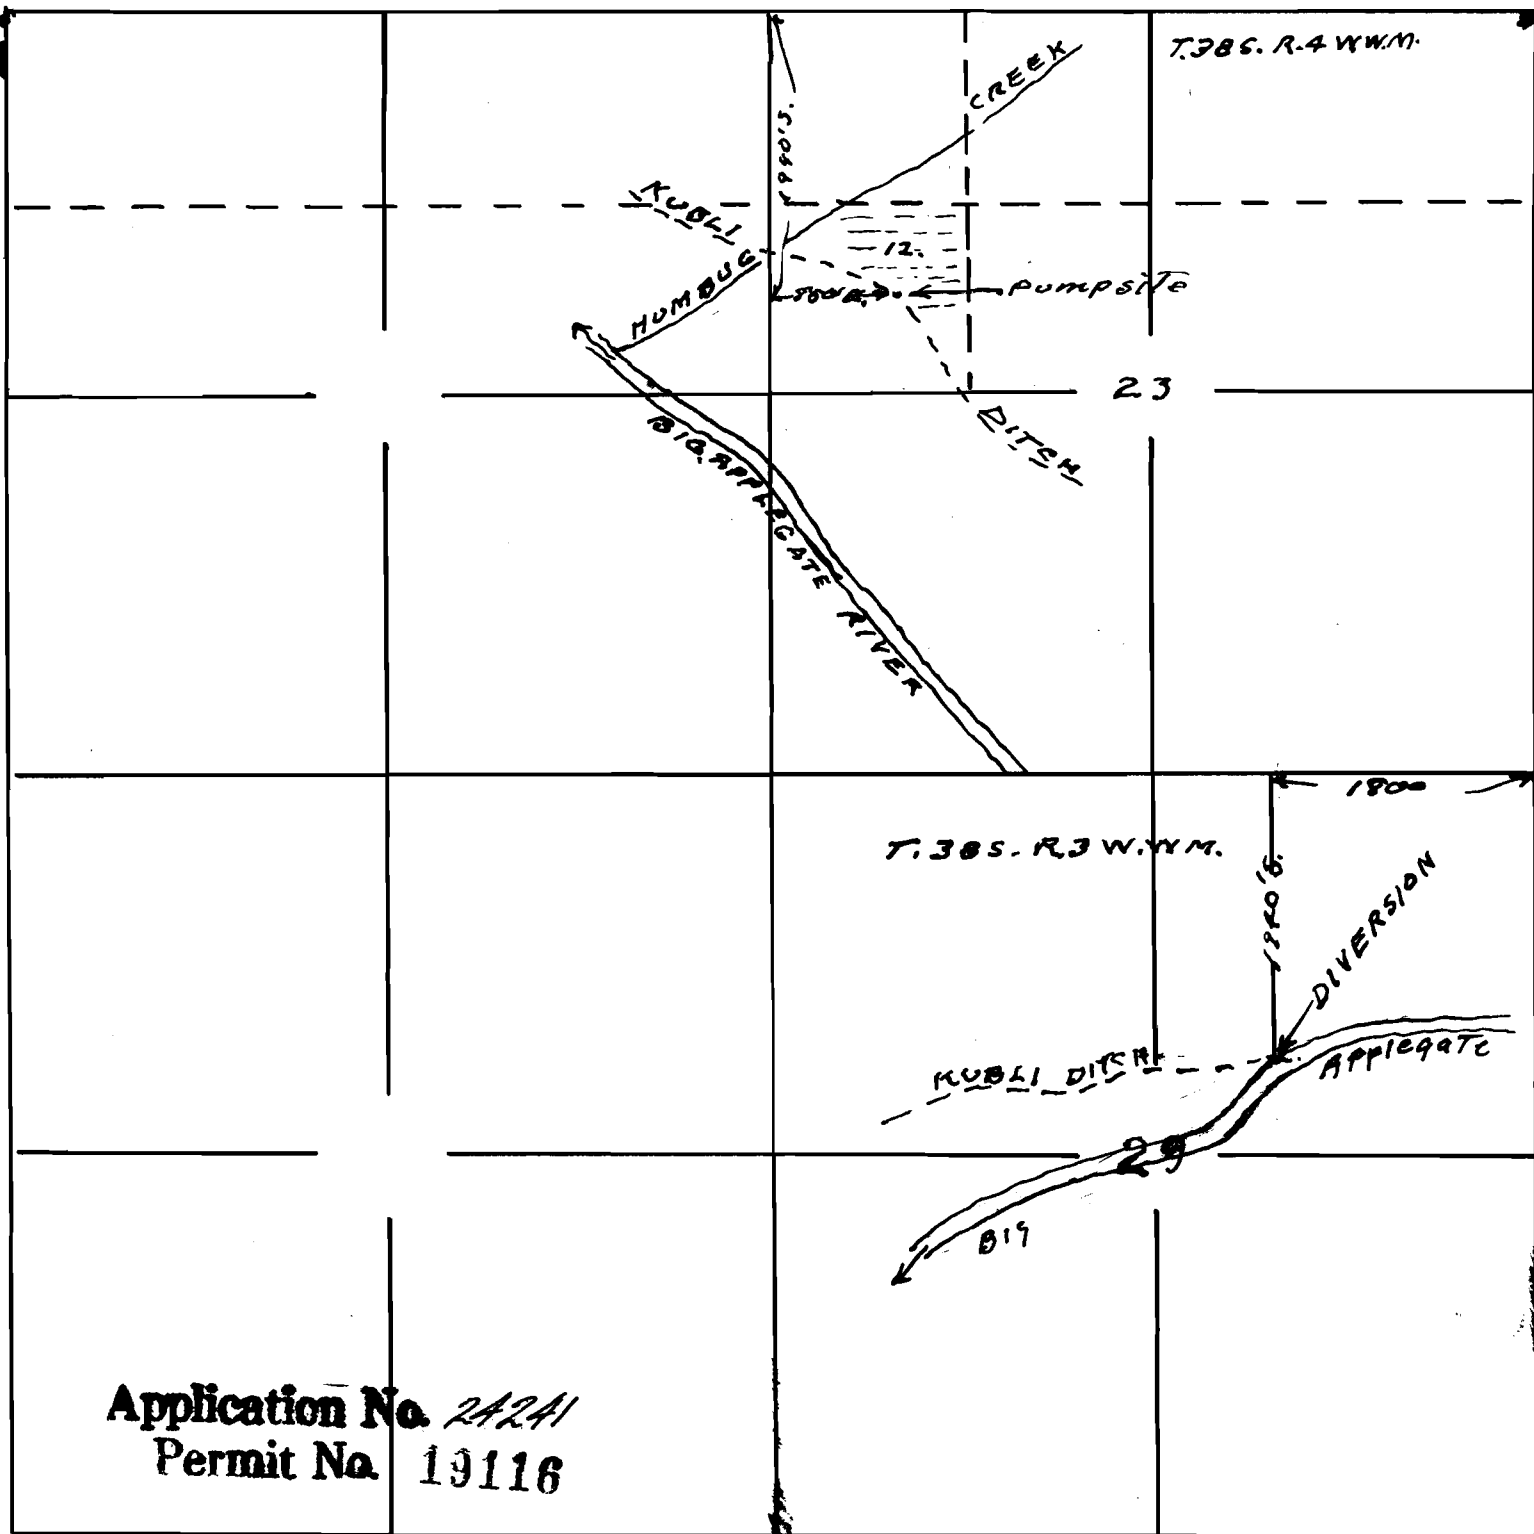

Application No. 24241  
Permit No. 19116

Map to accompany application of  
R. H. Poole for use of water from  
Big Applegate River for irrigation

This office 10/26/49 *[Signature]*

**RECEIVED**  
OCT 28 1949  
STATE ENGINEER  
SALEM, OREGON

24241

15-8A