


T. 36 S., R. 7 W., W.M.

Scale 8" = 1 Mile

Dec. 1949

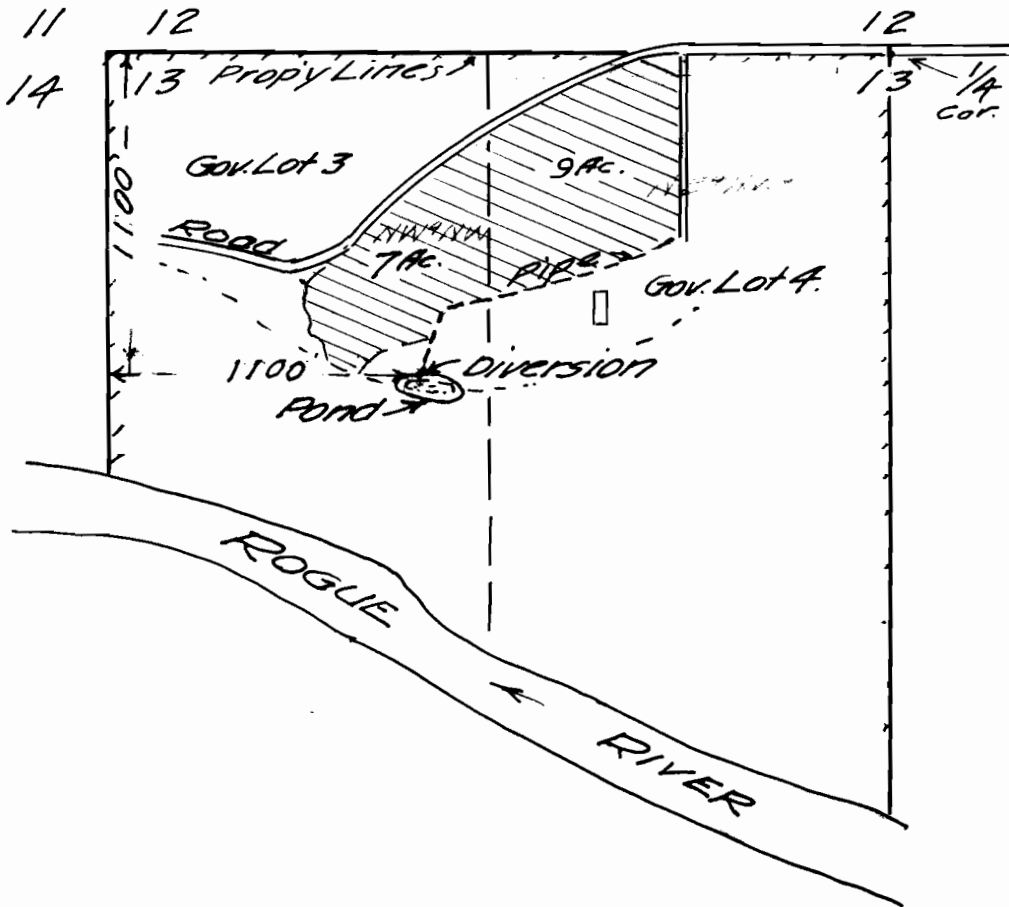

G. J. Klose

Application No. ~~24344~~
Permit No. 19136