


T.37 S., R.5 W., W.M.
Scale 4" = 1 Mile Dec. 1949.

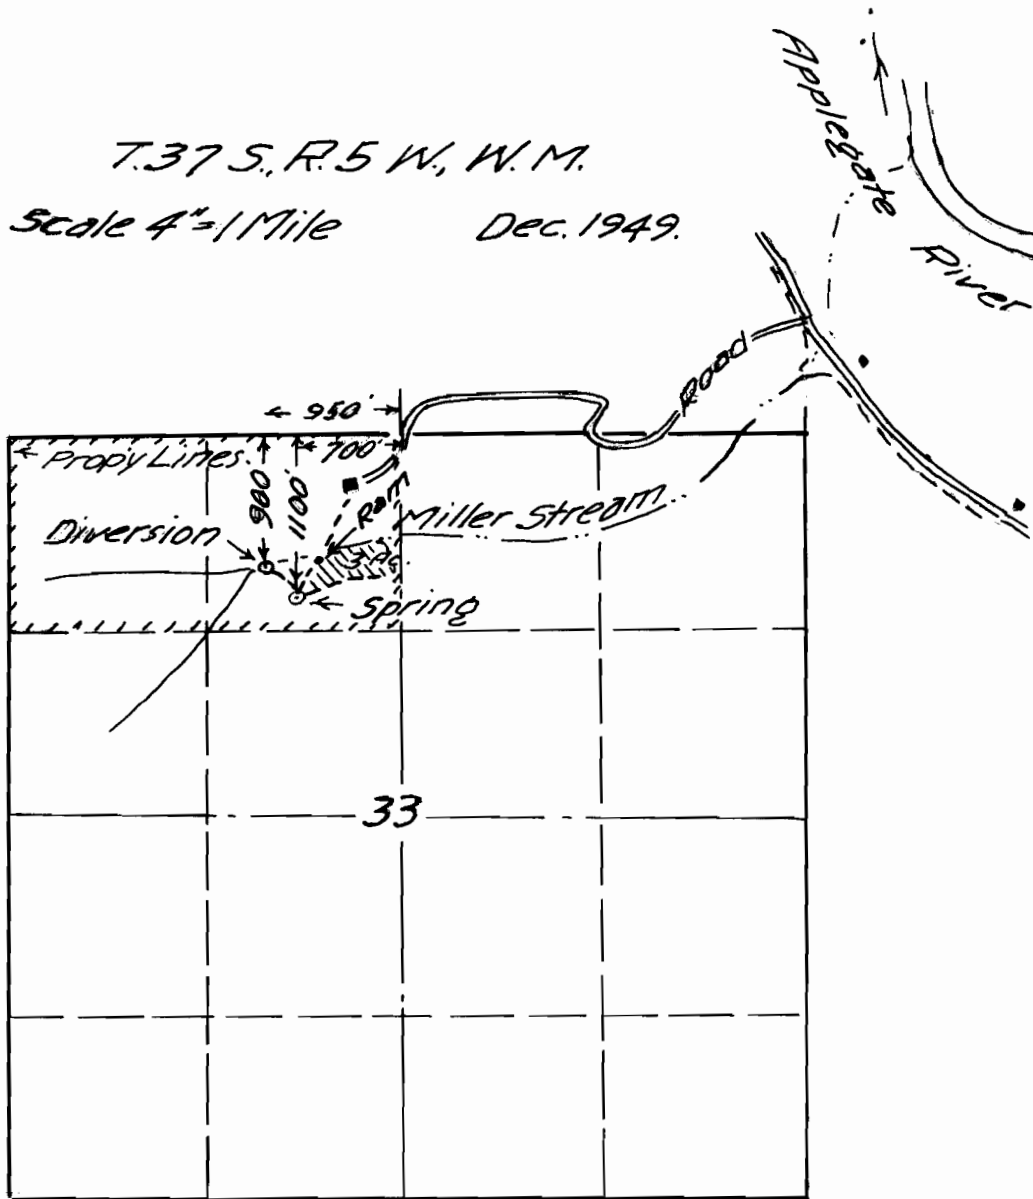

Archie Eugene Miller.

Application No. 24365

Permit No. 19142