


Sec. 16-21, T. 36 S. R. 4 W. W. M.

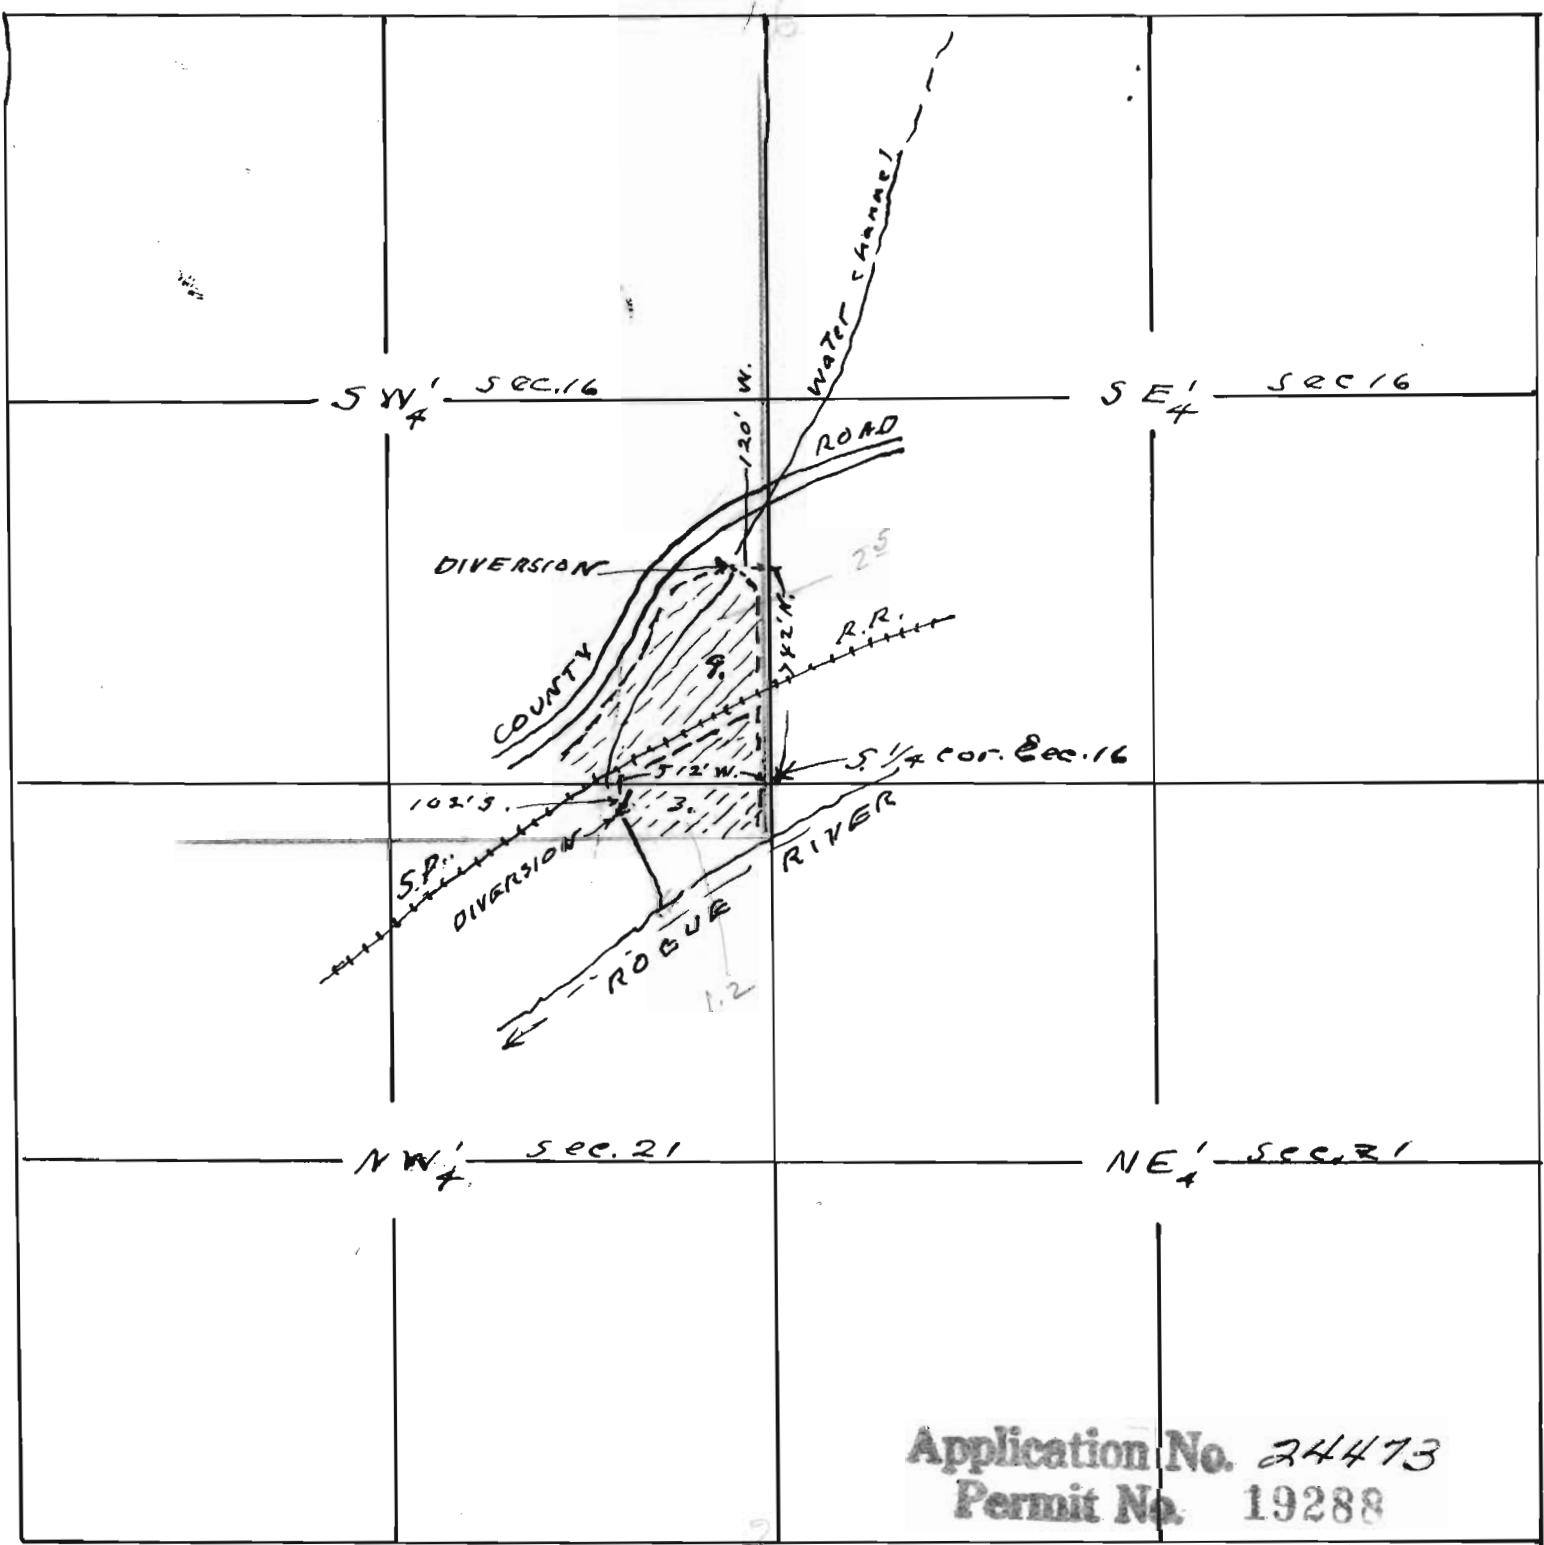

Application No. 24473  
Permit No. 19288

Map to accompany application of Henry Corbin for use of waste, runoff and escaped water also runs for irrigation purposes

This office 2/3/50 [Signature]

RECEIVED  
MAR 6 1957  
STATE ENGINEER  
SALEM, OREGON

24473

15-78H