


Sec. 1-6, T. 36 S. R. 1-2 W. W.M.

T. 36 S. R. 2 W

T. 36 S. R. 1 W

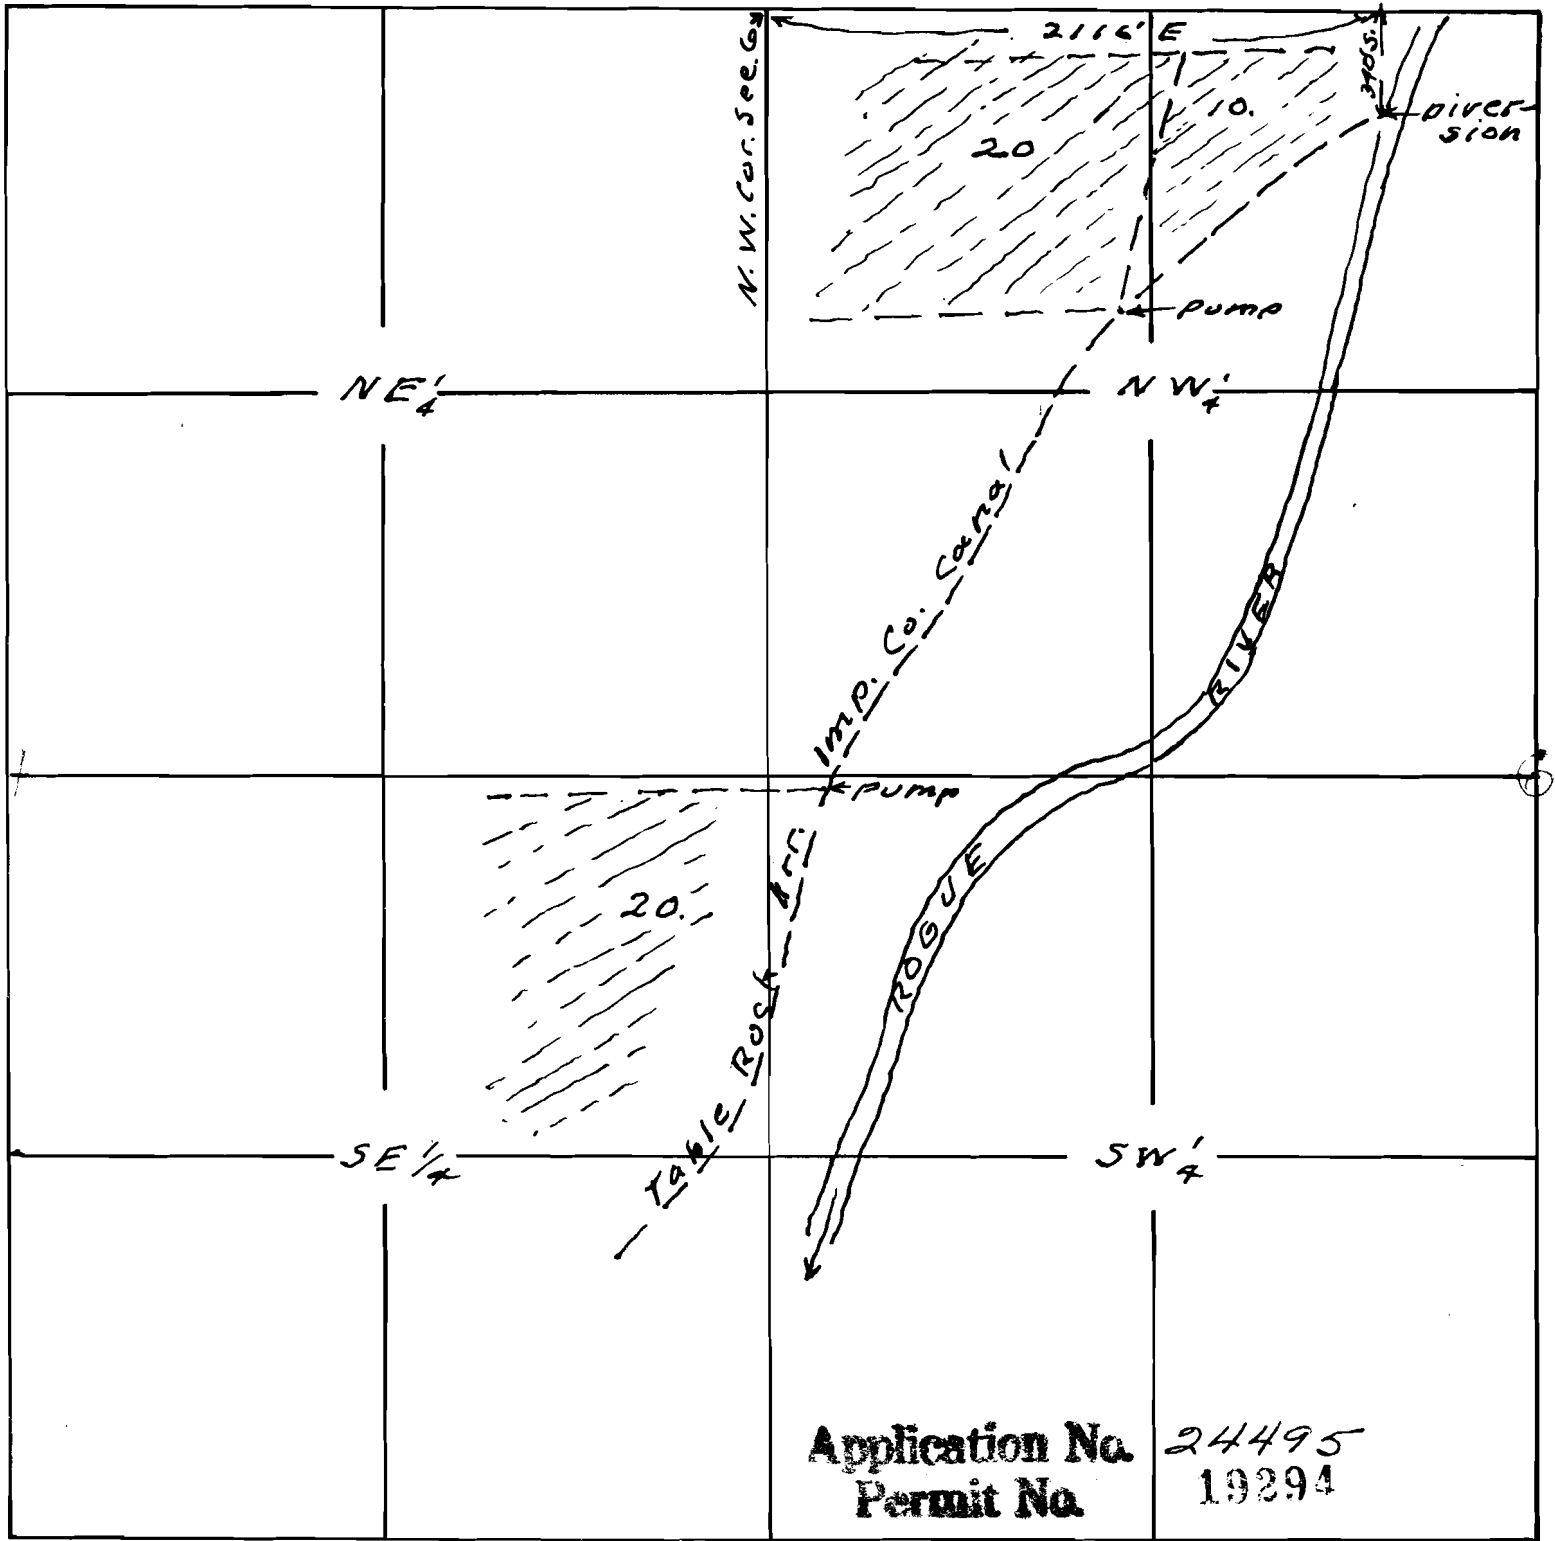

Map to accompany application of R. W. Ryan for use of water from Rogue River for irrigation

This office 3/8/50 Charles D. Smith W.M.

24495

15-60B