


Sec. 24.

Township 9 S.

Range 6 W.

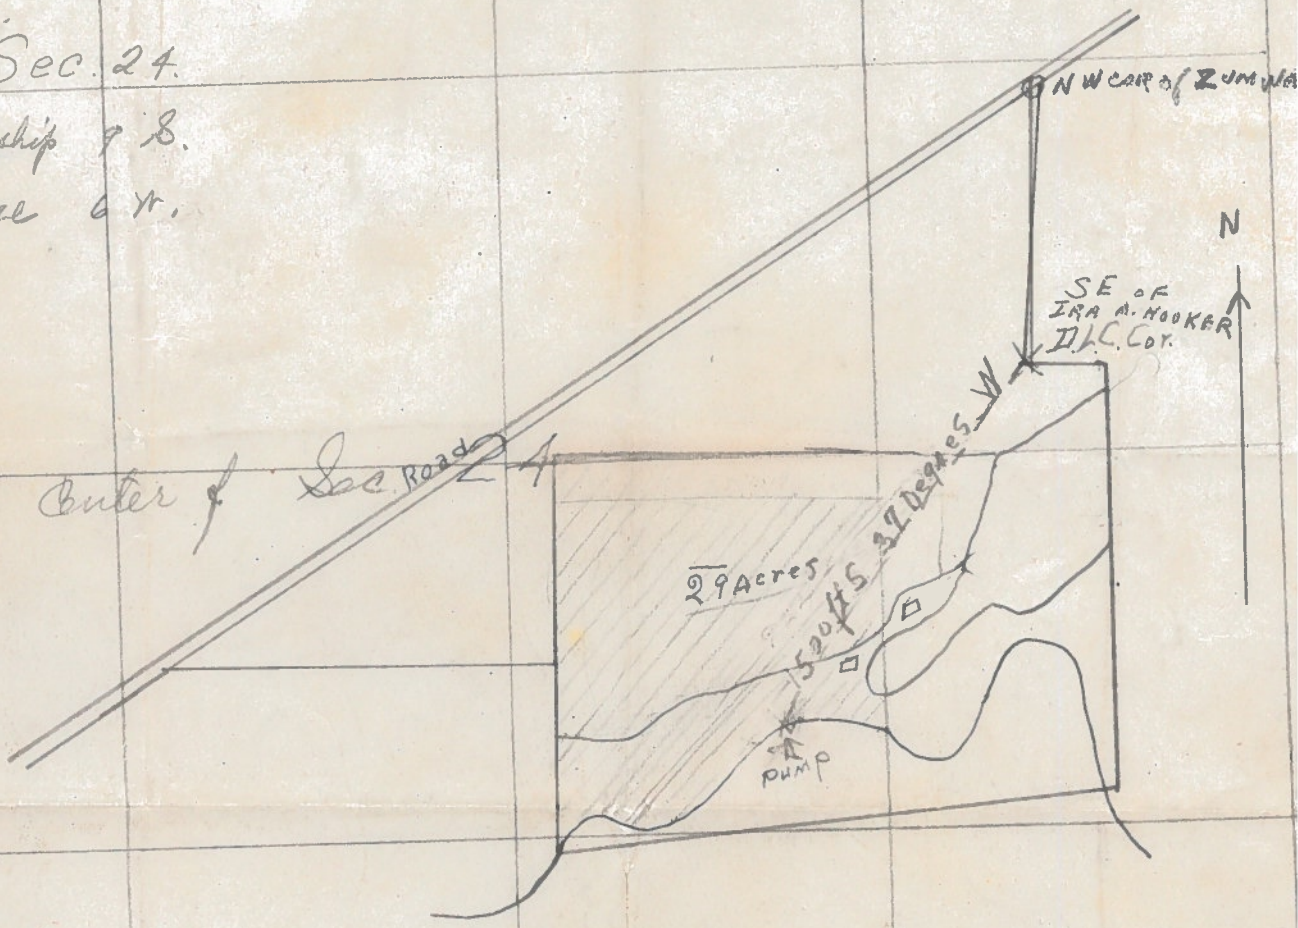

Map = DFP-3 D-24
 T9-R6-Sec 24

RECEIVED
 APR 4 1950
 STATE ENGINEER
 SALEM, OREGON

RECEIVED
 APR 10 1950
 STATE ENGINEER
 SALEM, OREGON

Application No. 24478
Permit No. 19349