


T.3& 45; R. 2 W.W.M.

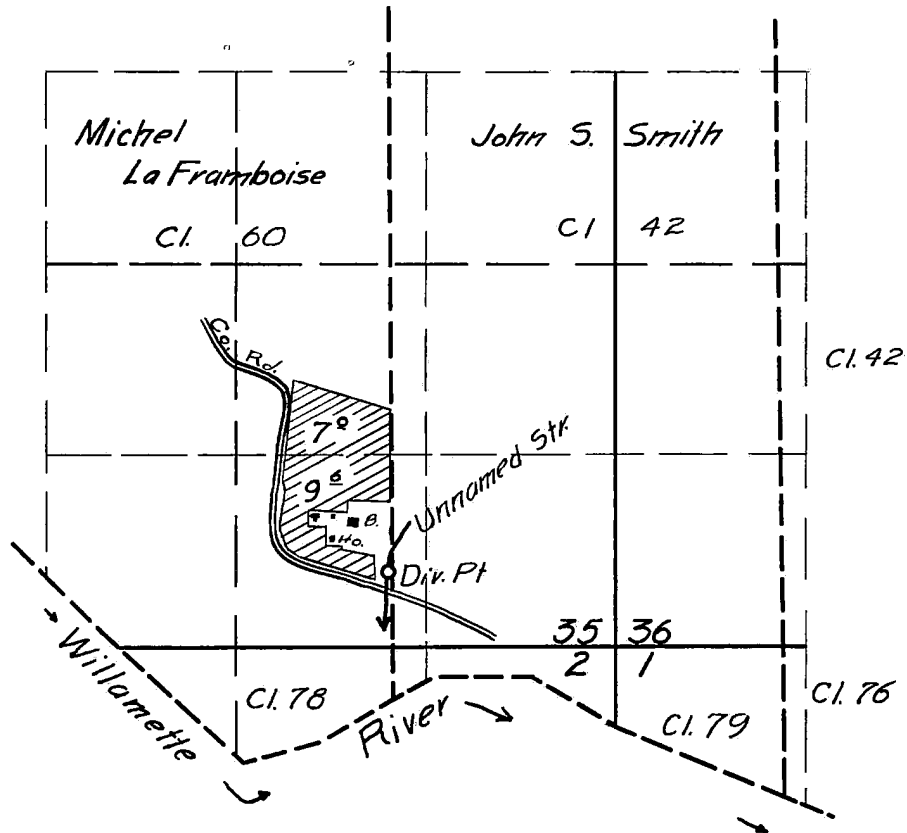

FINAL PROOF SURVEY

UNDER

Application No. 24553 Permit No. 19463

IN NAME OF

T. H. MILLER

Surveyed 20 September 1955, by Robert H. Best