RECEIVED
JUL 30 1950
STATE ENGINEER
SALEM, OREGON

RECEIVED
STATE ENGINEER
SALEM, OREGON

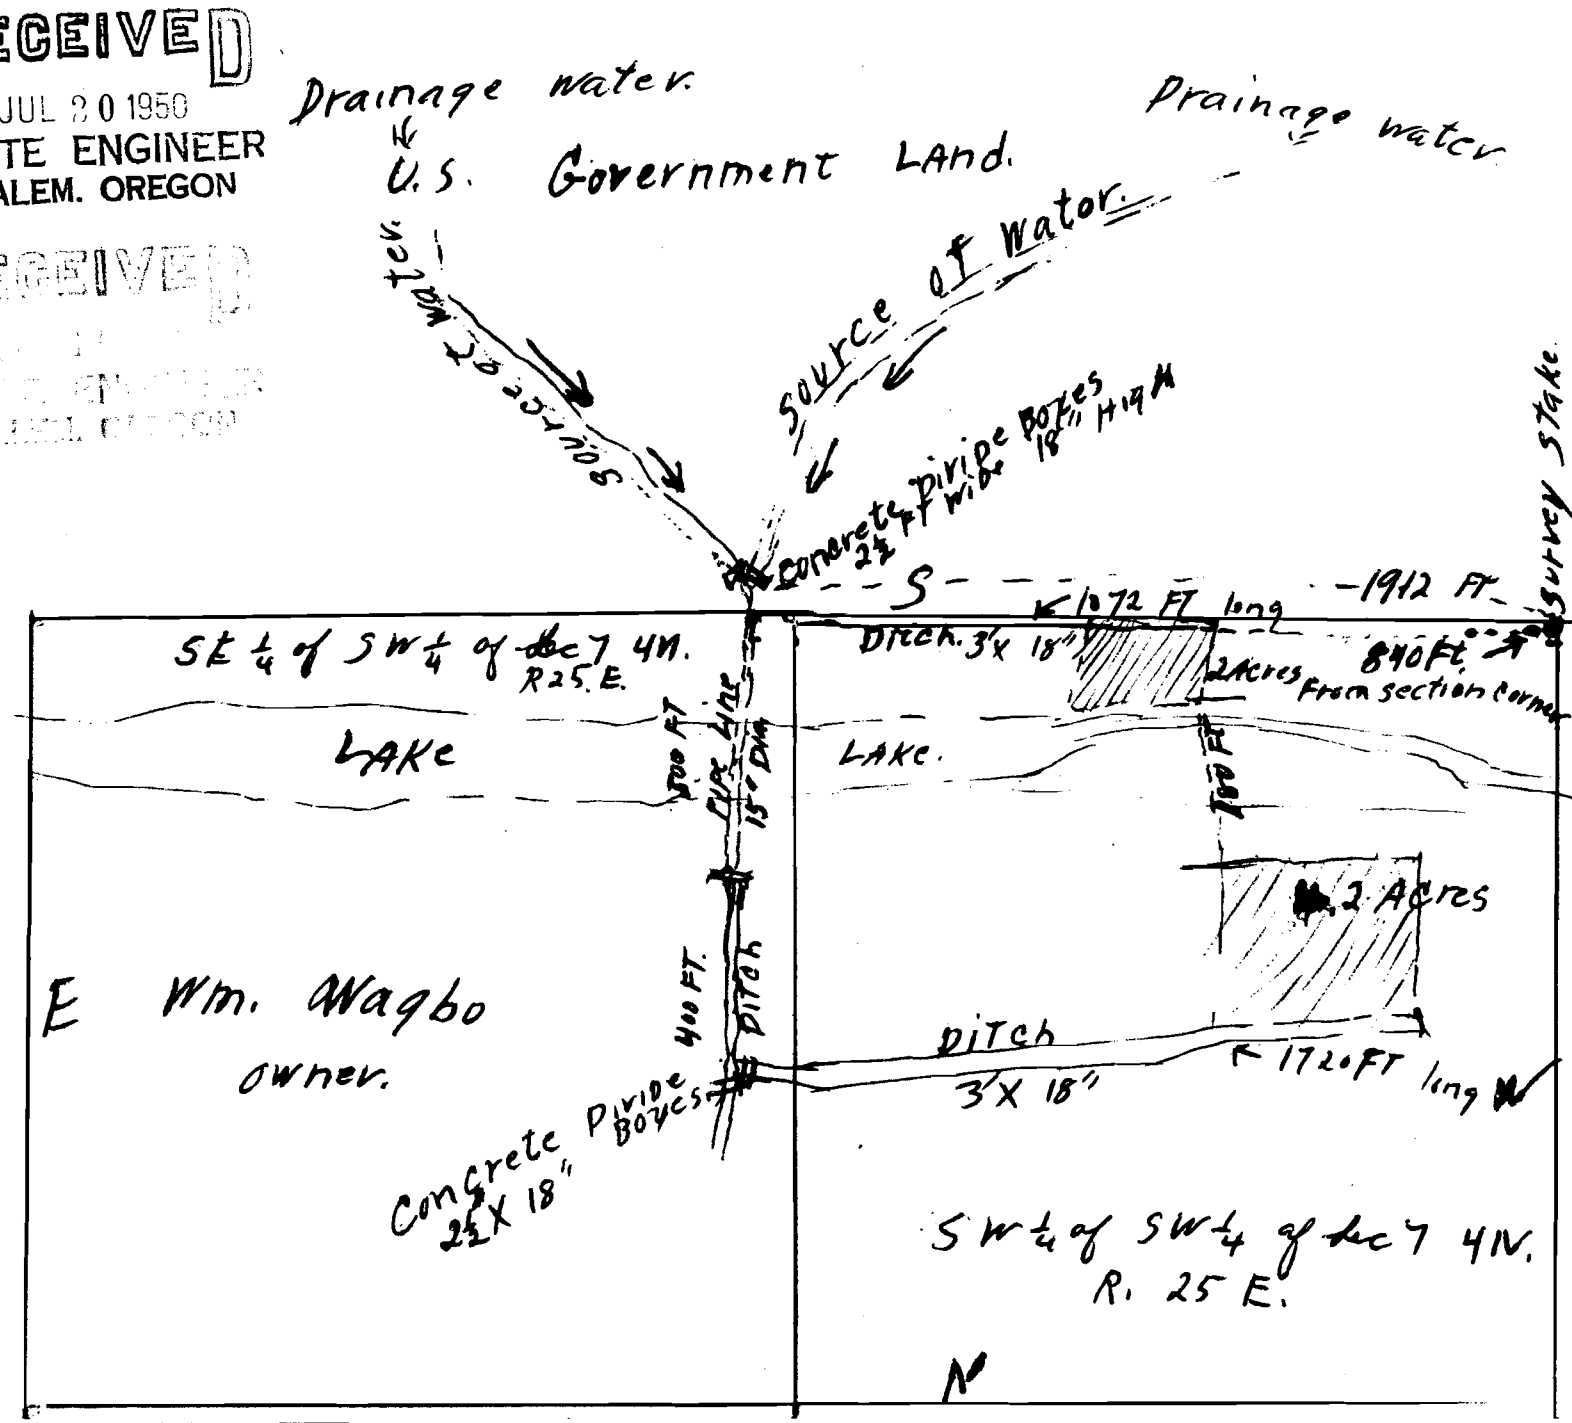

Application No. 24688
Permit No. 19487