


Verne H. Wilson  
Application No. 248 P. 19572  
Permit No. 19572  
Priority - June 14, 1950  
Find in Rogue River, Vol. 1

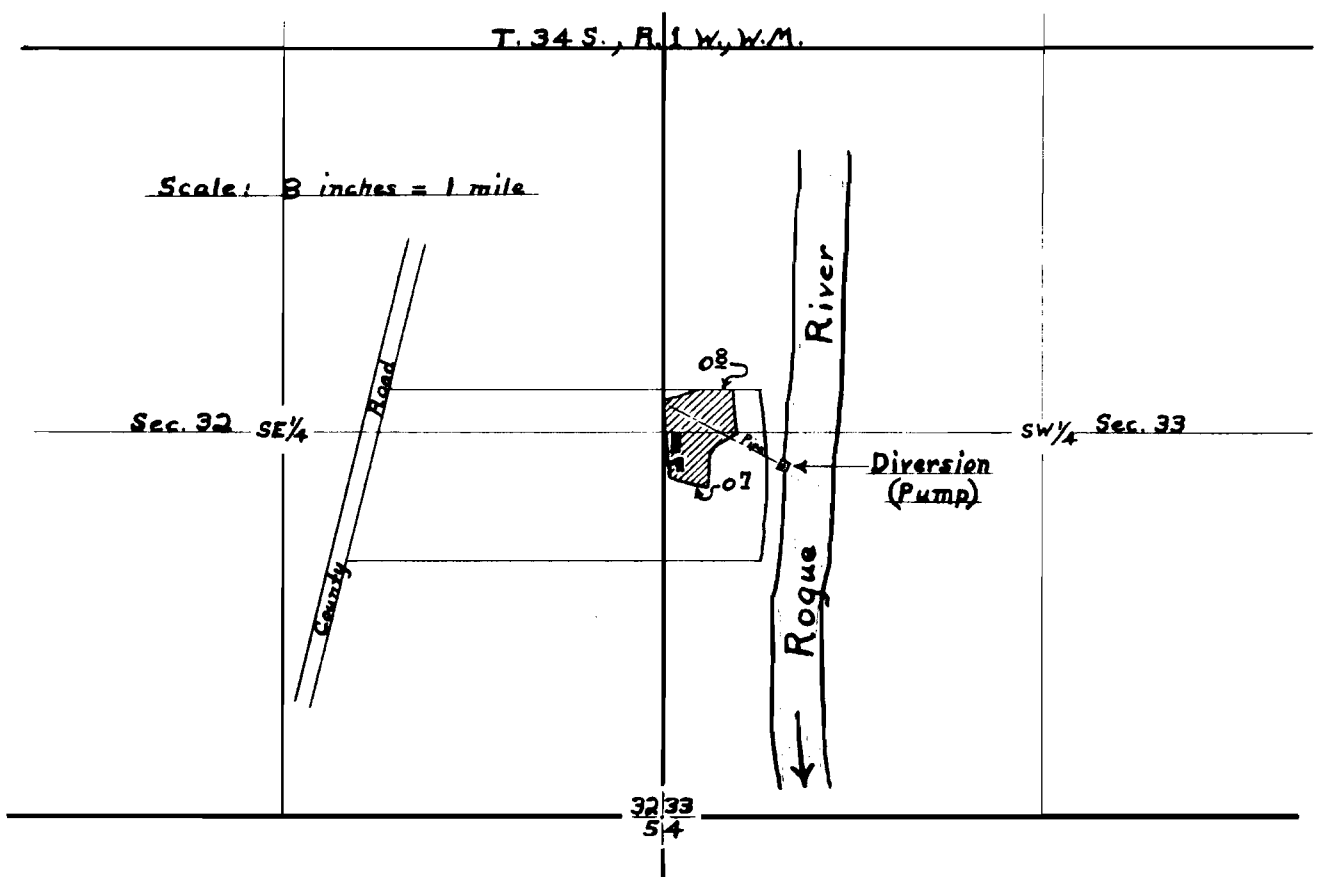

### FINAL PROOF SURVEY

UNDER

Application No. 24873 Permit No. 19572 *CRAT. # 22186*  
IN NAME OF

Verne H. Wilson

Surveyed Jan. 18 1957, by D.C. Hendrix, W.M.

*1919 6/18/50*