


Township 36 South

Range 6 West W.M.

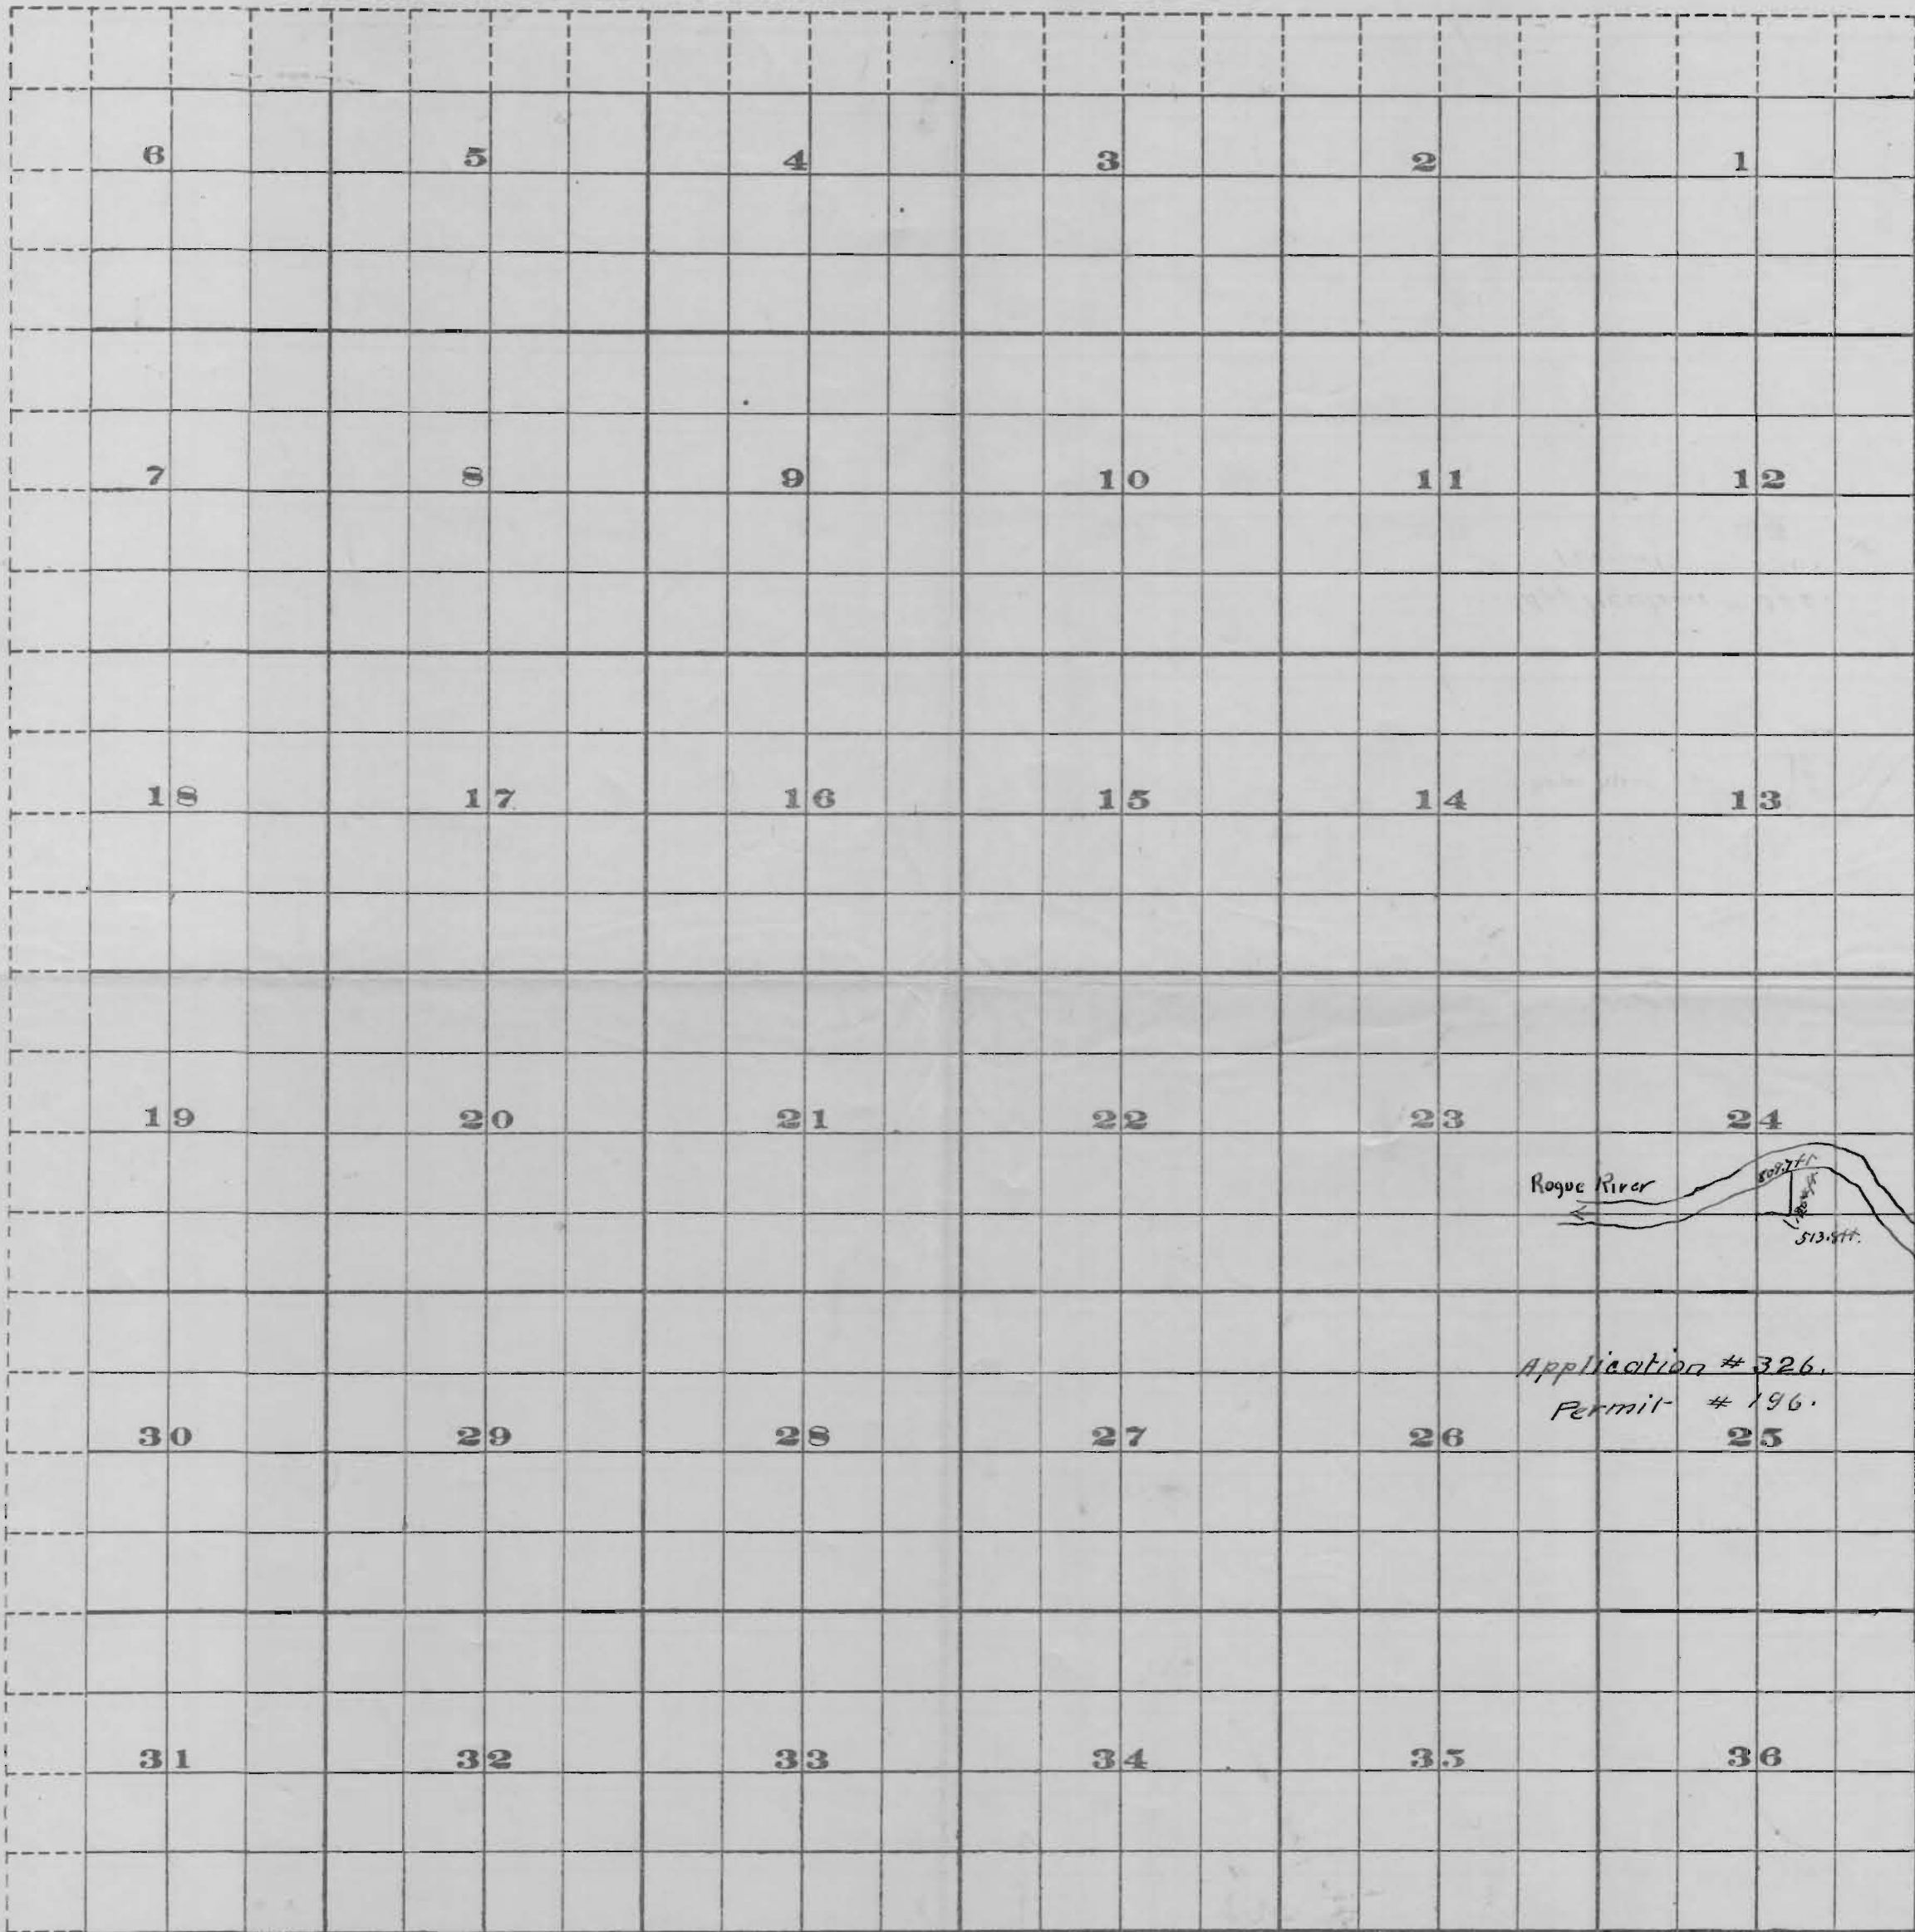

2
h
5/11

FROM OFFICE OF THE STATE ENGINEER, SALEM, OREGON

Scale of Feet.

359

359