RECEIVED
AUG 17 1950
STATE ENGINEER
SALEM, OREGON

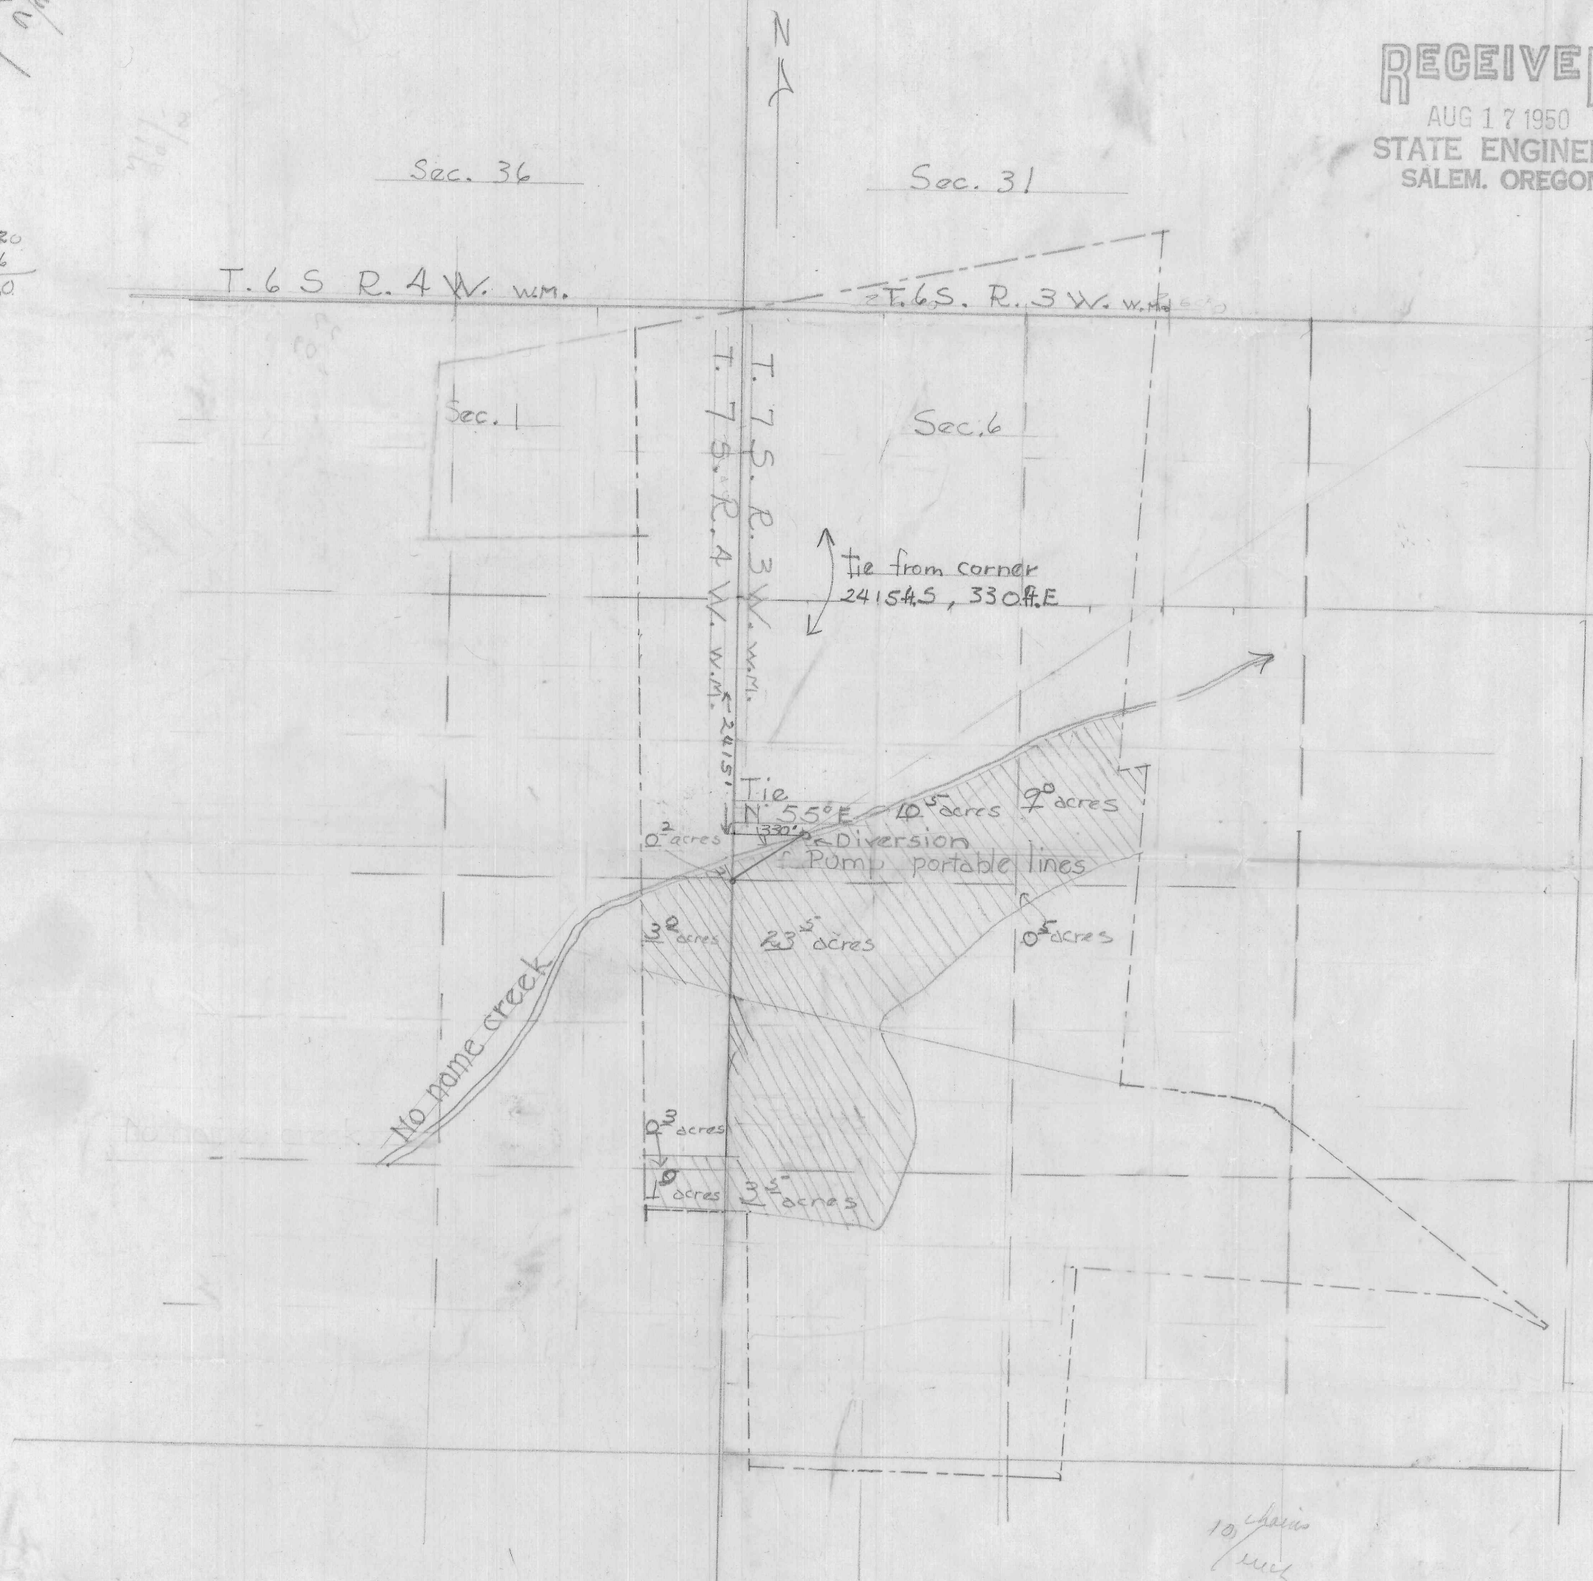

Application No. 24947
Permit No. 19692

Map by Eunice C. Brandt, O.S.L.A. Landscape Architect
Scale 10 chains per inch August 6, 1950

Note boom