


Township 36 South,


Range 6 West 15m.

w
eg
✓

1
35
3

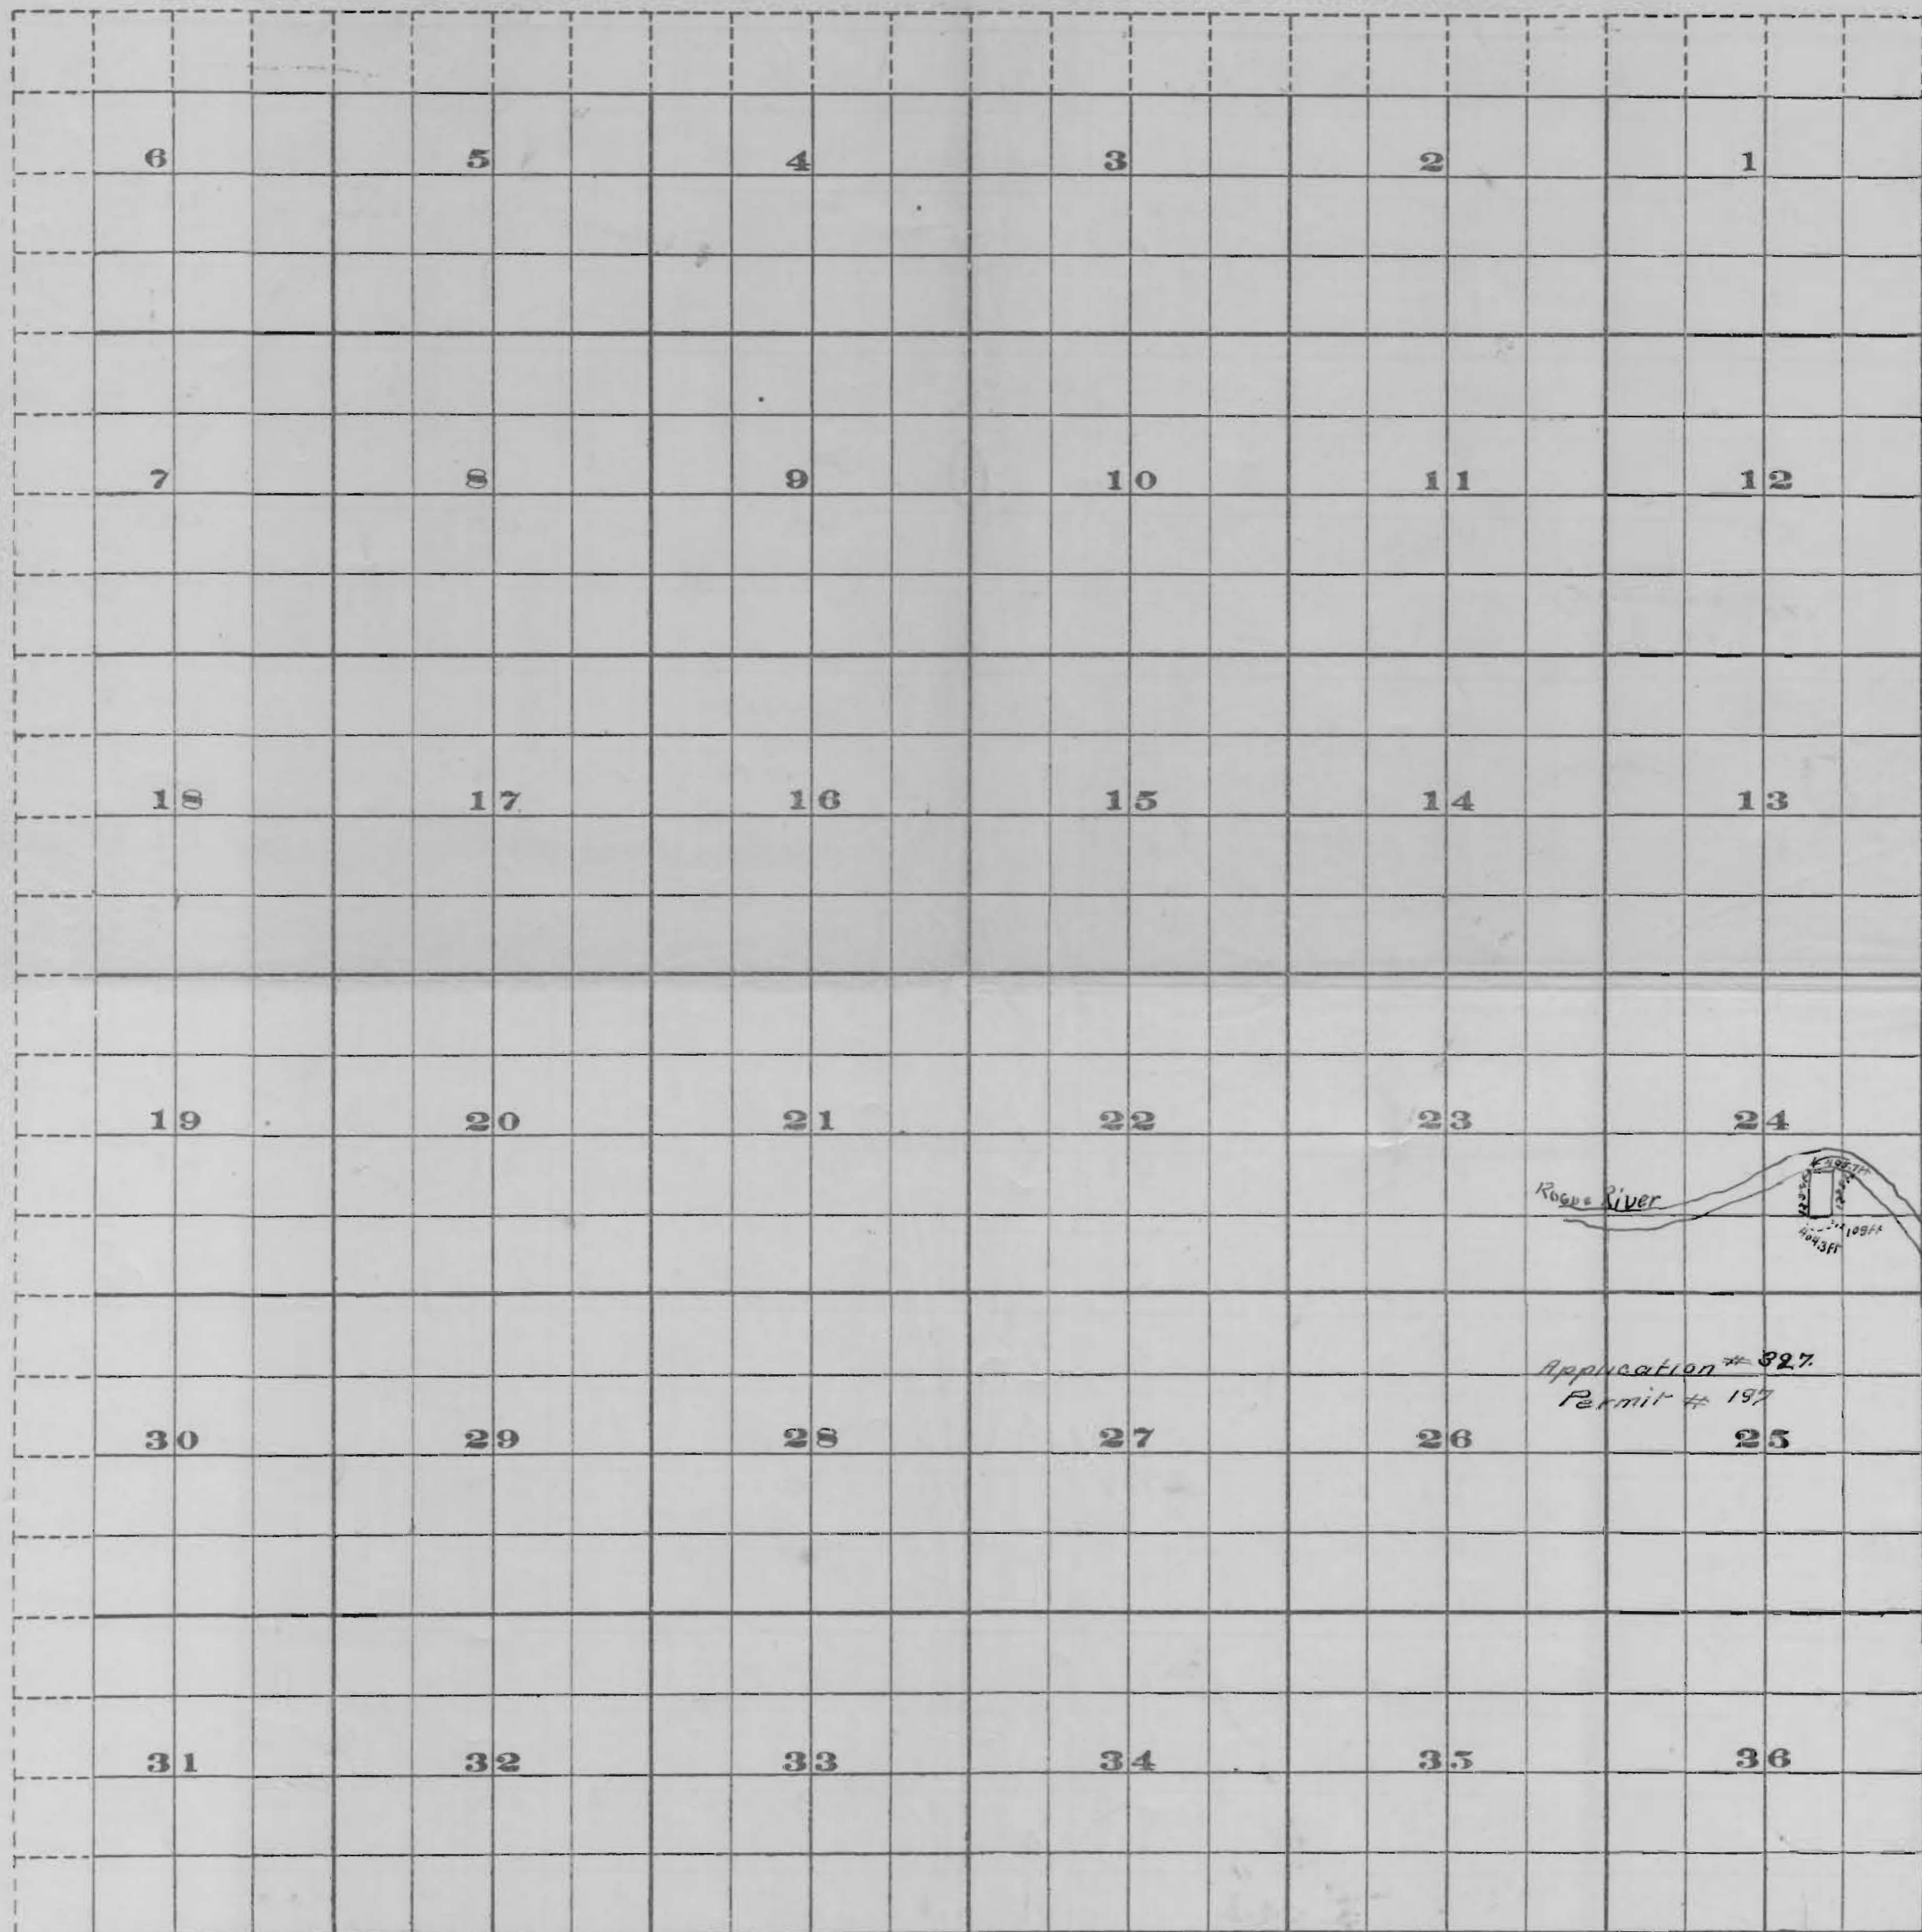

327.

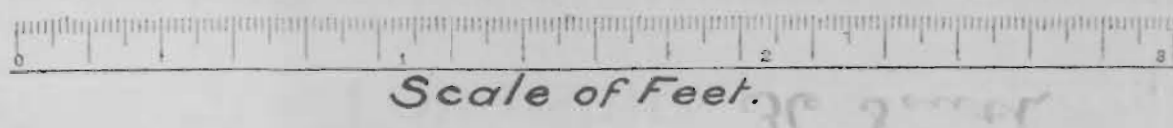

FROM OFFICE OF THE STATE ENGINEER, SALEM, OREGON

30 2000'

12-11'