


SEC 17, T. 36 S., R. 3 W. W.M.

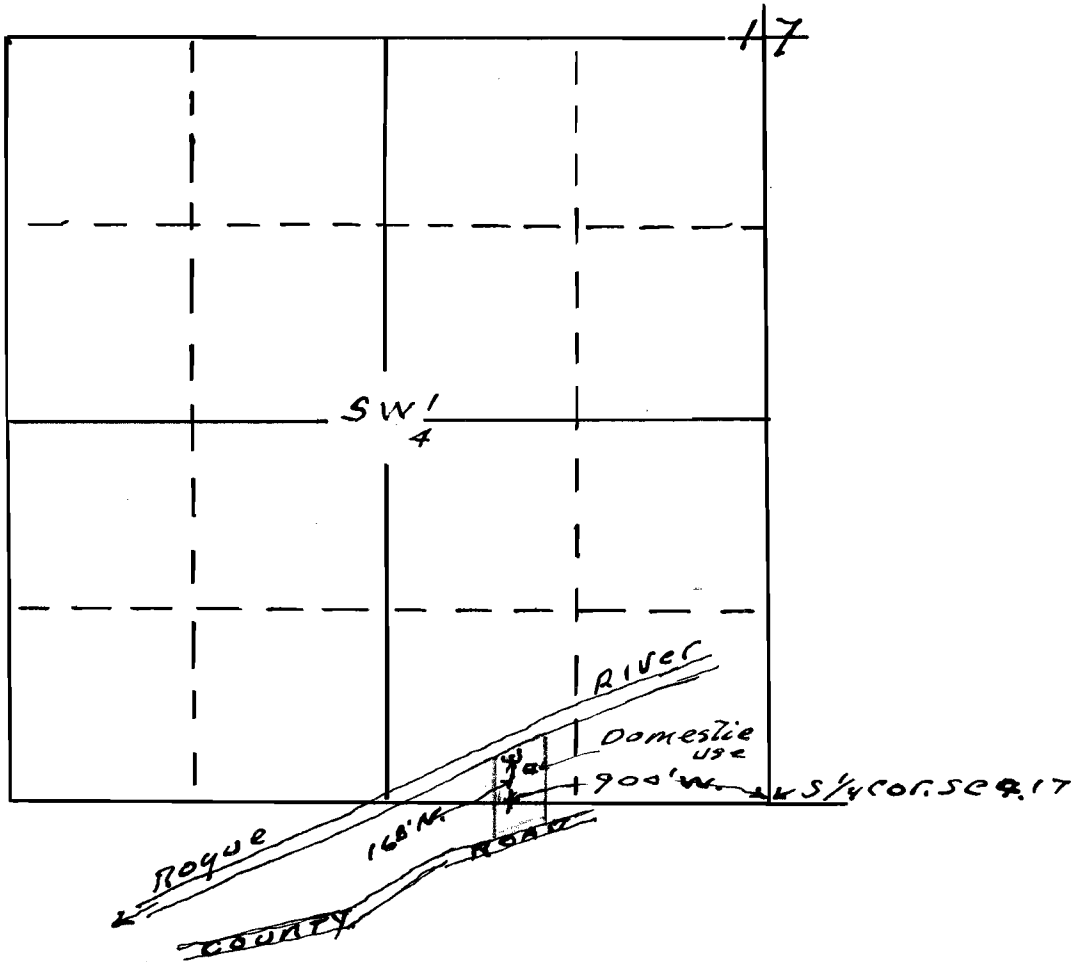

Map to accompany application of  
Russel P. Sensen for use of private  
spring for domestic purposes.

This office 7/20/50 *W. H. Smith*

Application No. 25022  
Permit No. 19714