


T. 37 S., R. 6 W., W. 1 M

Scale 4" = 1 Mile.

July 1950

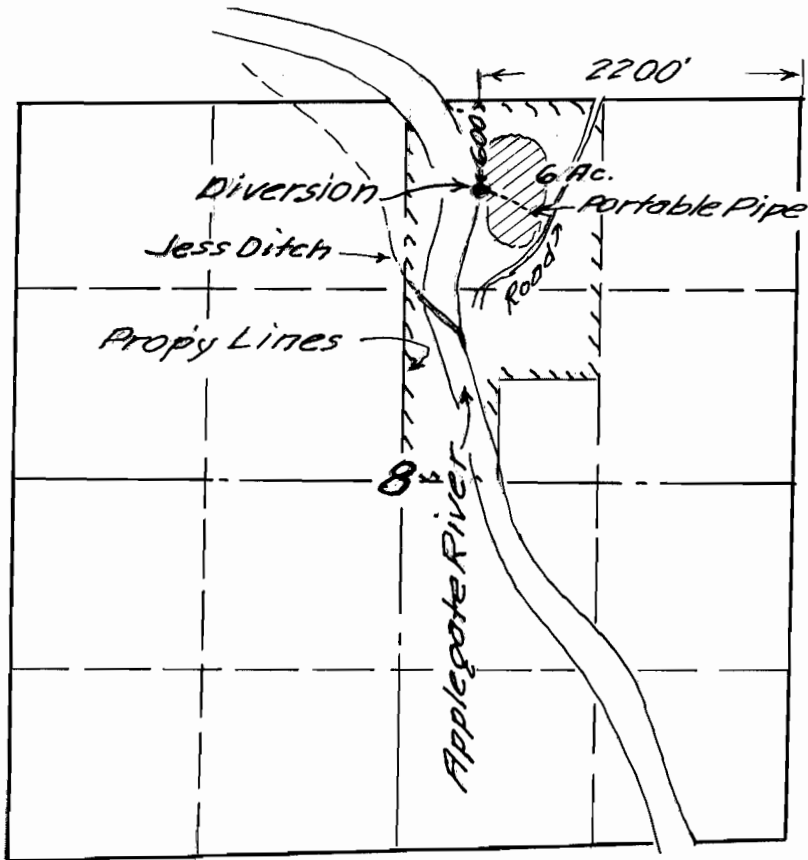

Howard O. Bushnell.

Application No. 25041

Permit No. 19726

RECEIVED
JUL 26 1950
STATE ENGINEER
SALEM, OREGON