


Sec. 13, T. 39 S., R. 1 E W.M.

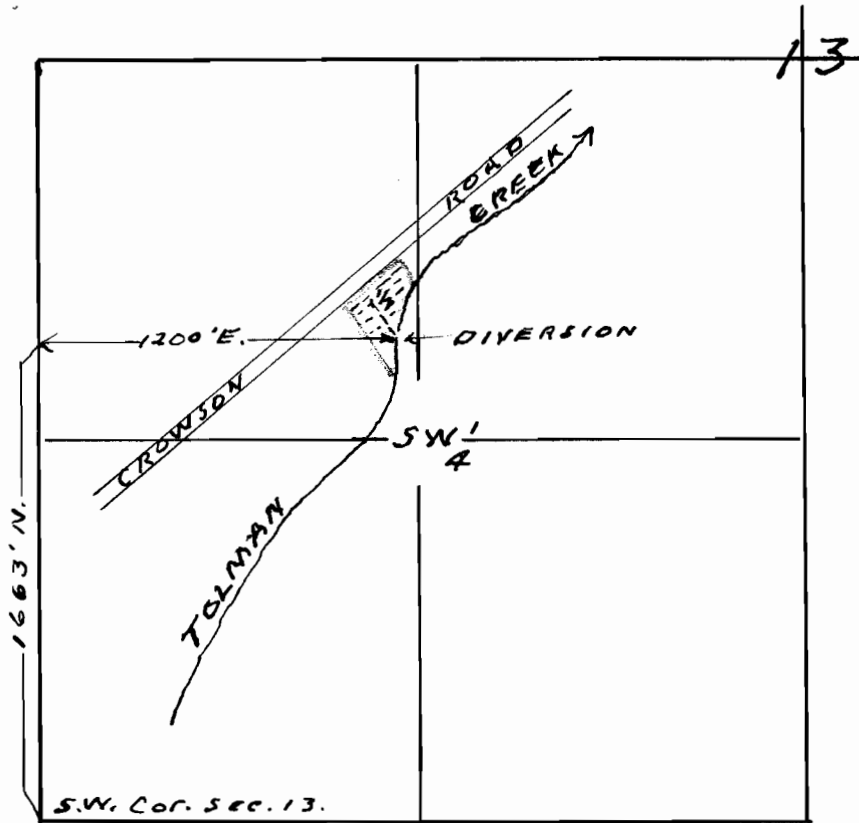

Map to accompany application of
E.L. Johnson for use of water from
Tolman Creek for irrigation.

this office 7/27/50 *Olinde Lubowitz*

Application No. 25063
Permit No. 19736