


T. 35 S., R. 6 W., W. M.  
Scale 4" = 1 Mile. Sept. 1950

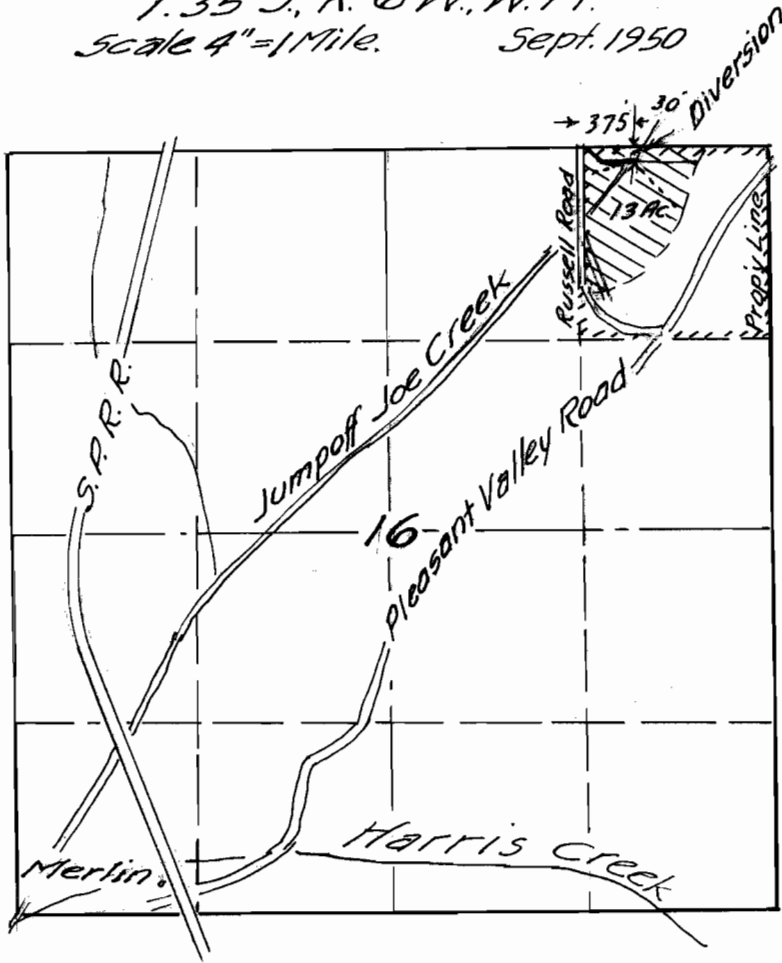

Wayne Russell

RECEIVED  
MAY 1951

Application No. 25280  
Permit No. 19852