T. 33 S., R. 7 W., W.M.

Scale 4" = 1 Mile Sept. 1950

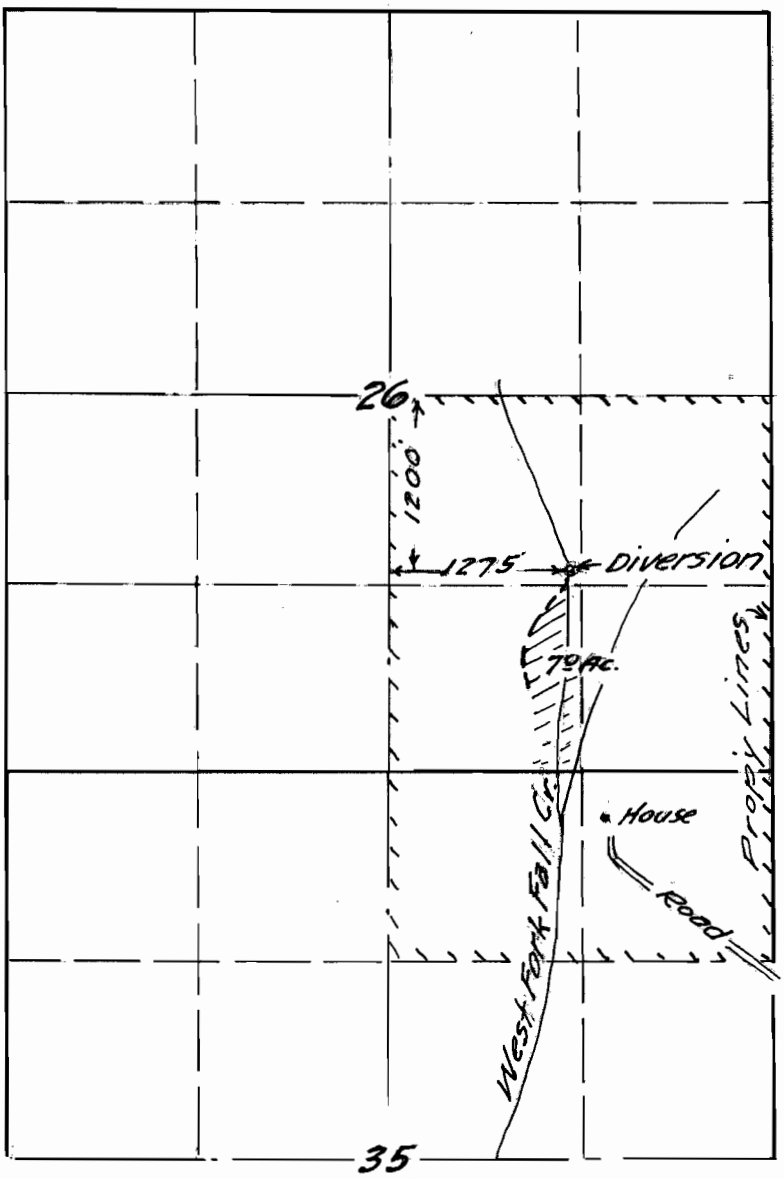

E. L. Burch.

Application No. 25320

Permit No. 79870