

23

T. 5N., R. 7W., W.M.

1

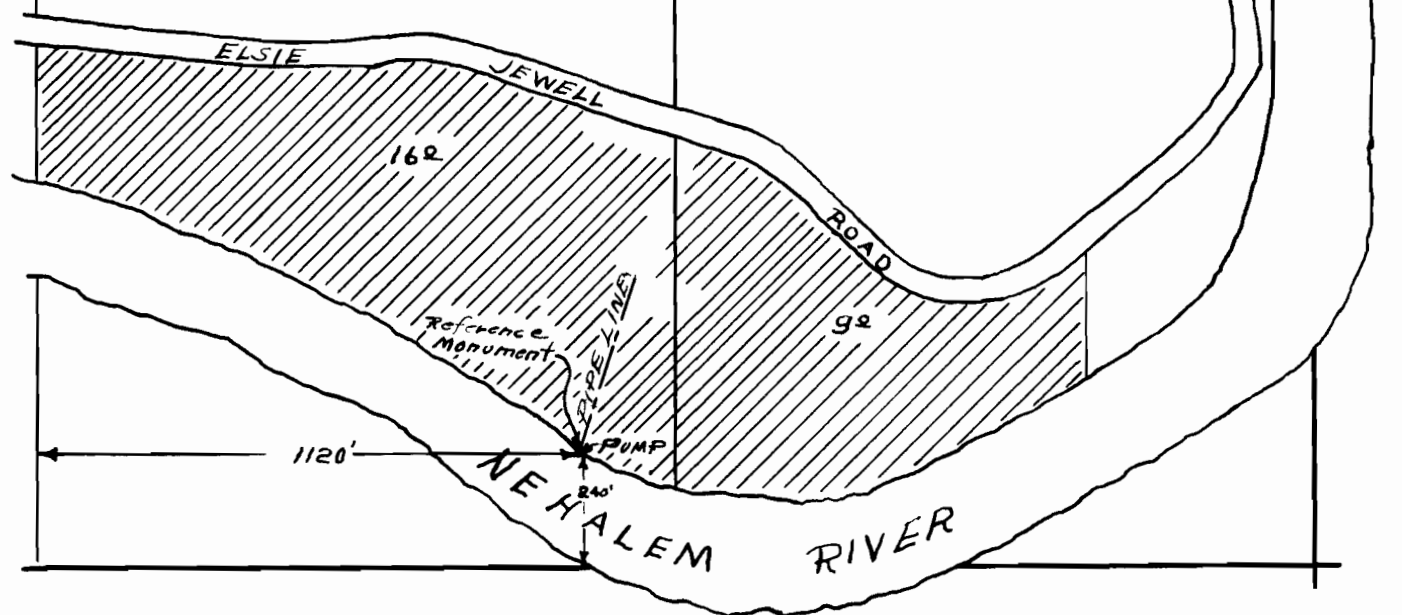
RECEIVED

NOV 15 1950

STATE ENGINEER
SALEM OREGON

3

2

Application No. 25434
Permit No. 19904

SCALE 1" = 400'