


T. 7 S. R. 38 E. W. M.

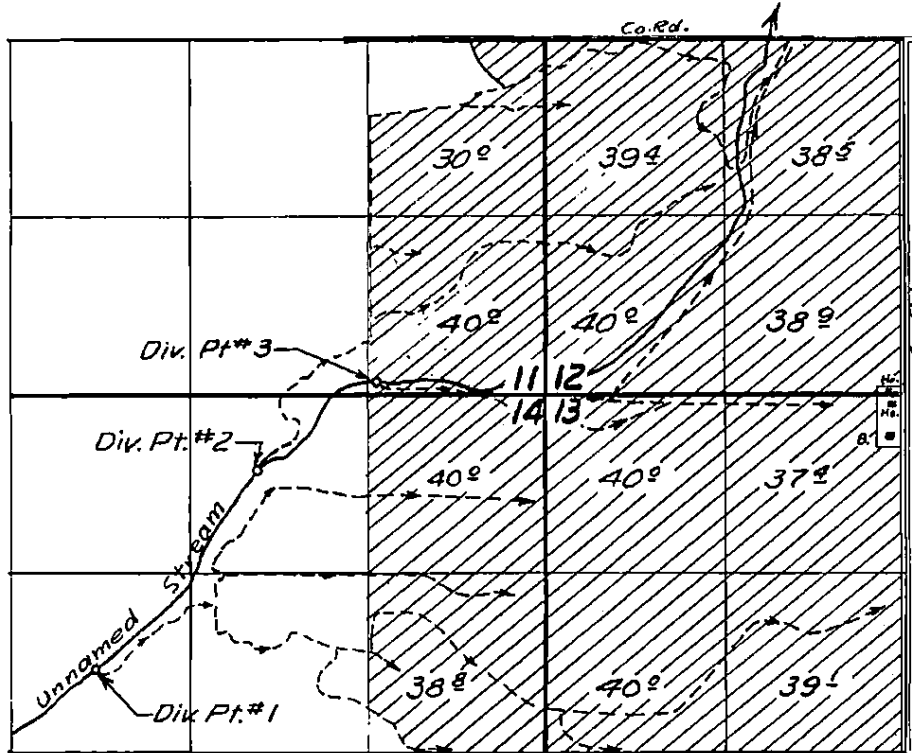

**FINAL PROOF SURVEY**

UNDER

Application No. 24466. Permit No. 19907.

IN NAME OF

*Clara M. Welch, Roy Welch, Roy Welch & Emma B. Fisher*

Surveyed 27 May 1956, by *Tom Bishop*