


Section 4
Township 1 S
Range 2 W. W. M.

4 3

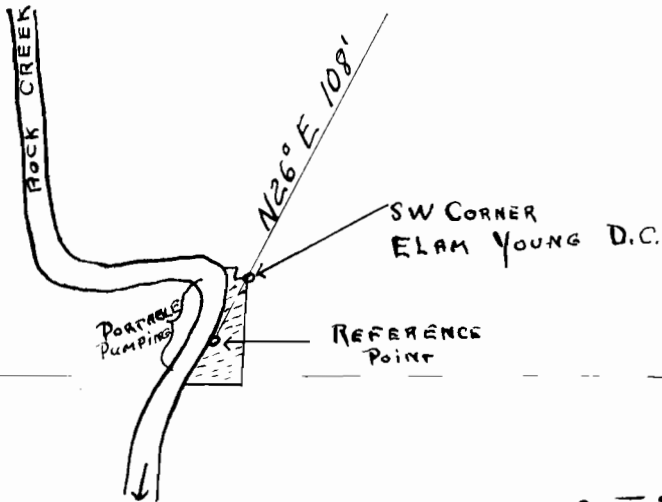

PROPERTY OF - ED. H. BERGIN

Application No. 25210
Permit No. 131125