


CARMEN CREEK INLET

CARMEN CREEK WATER DISTRICT
MAP SCALE
1" = 100'

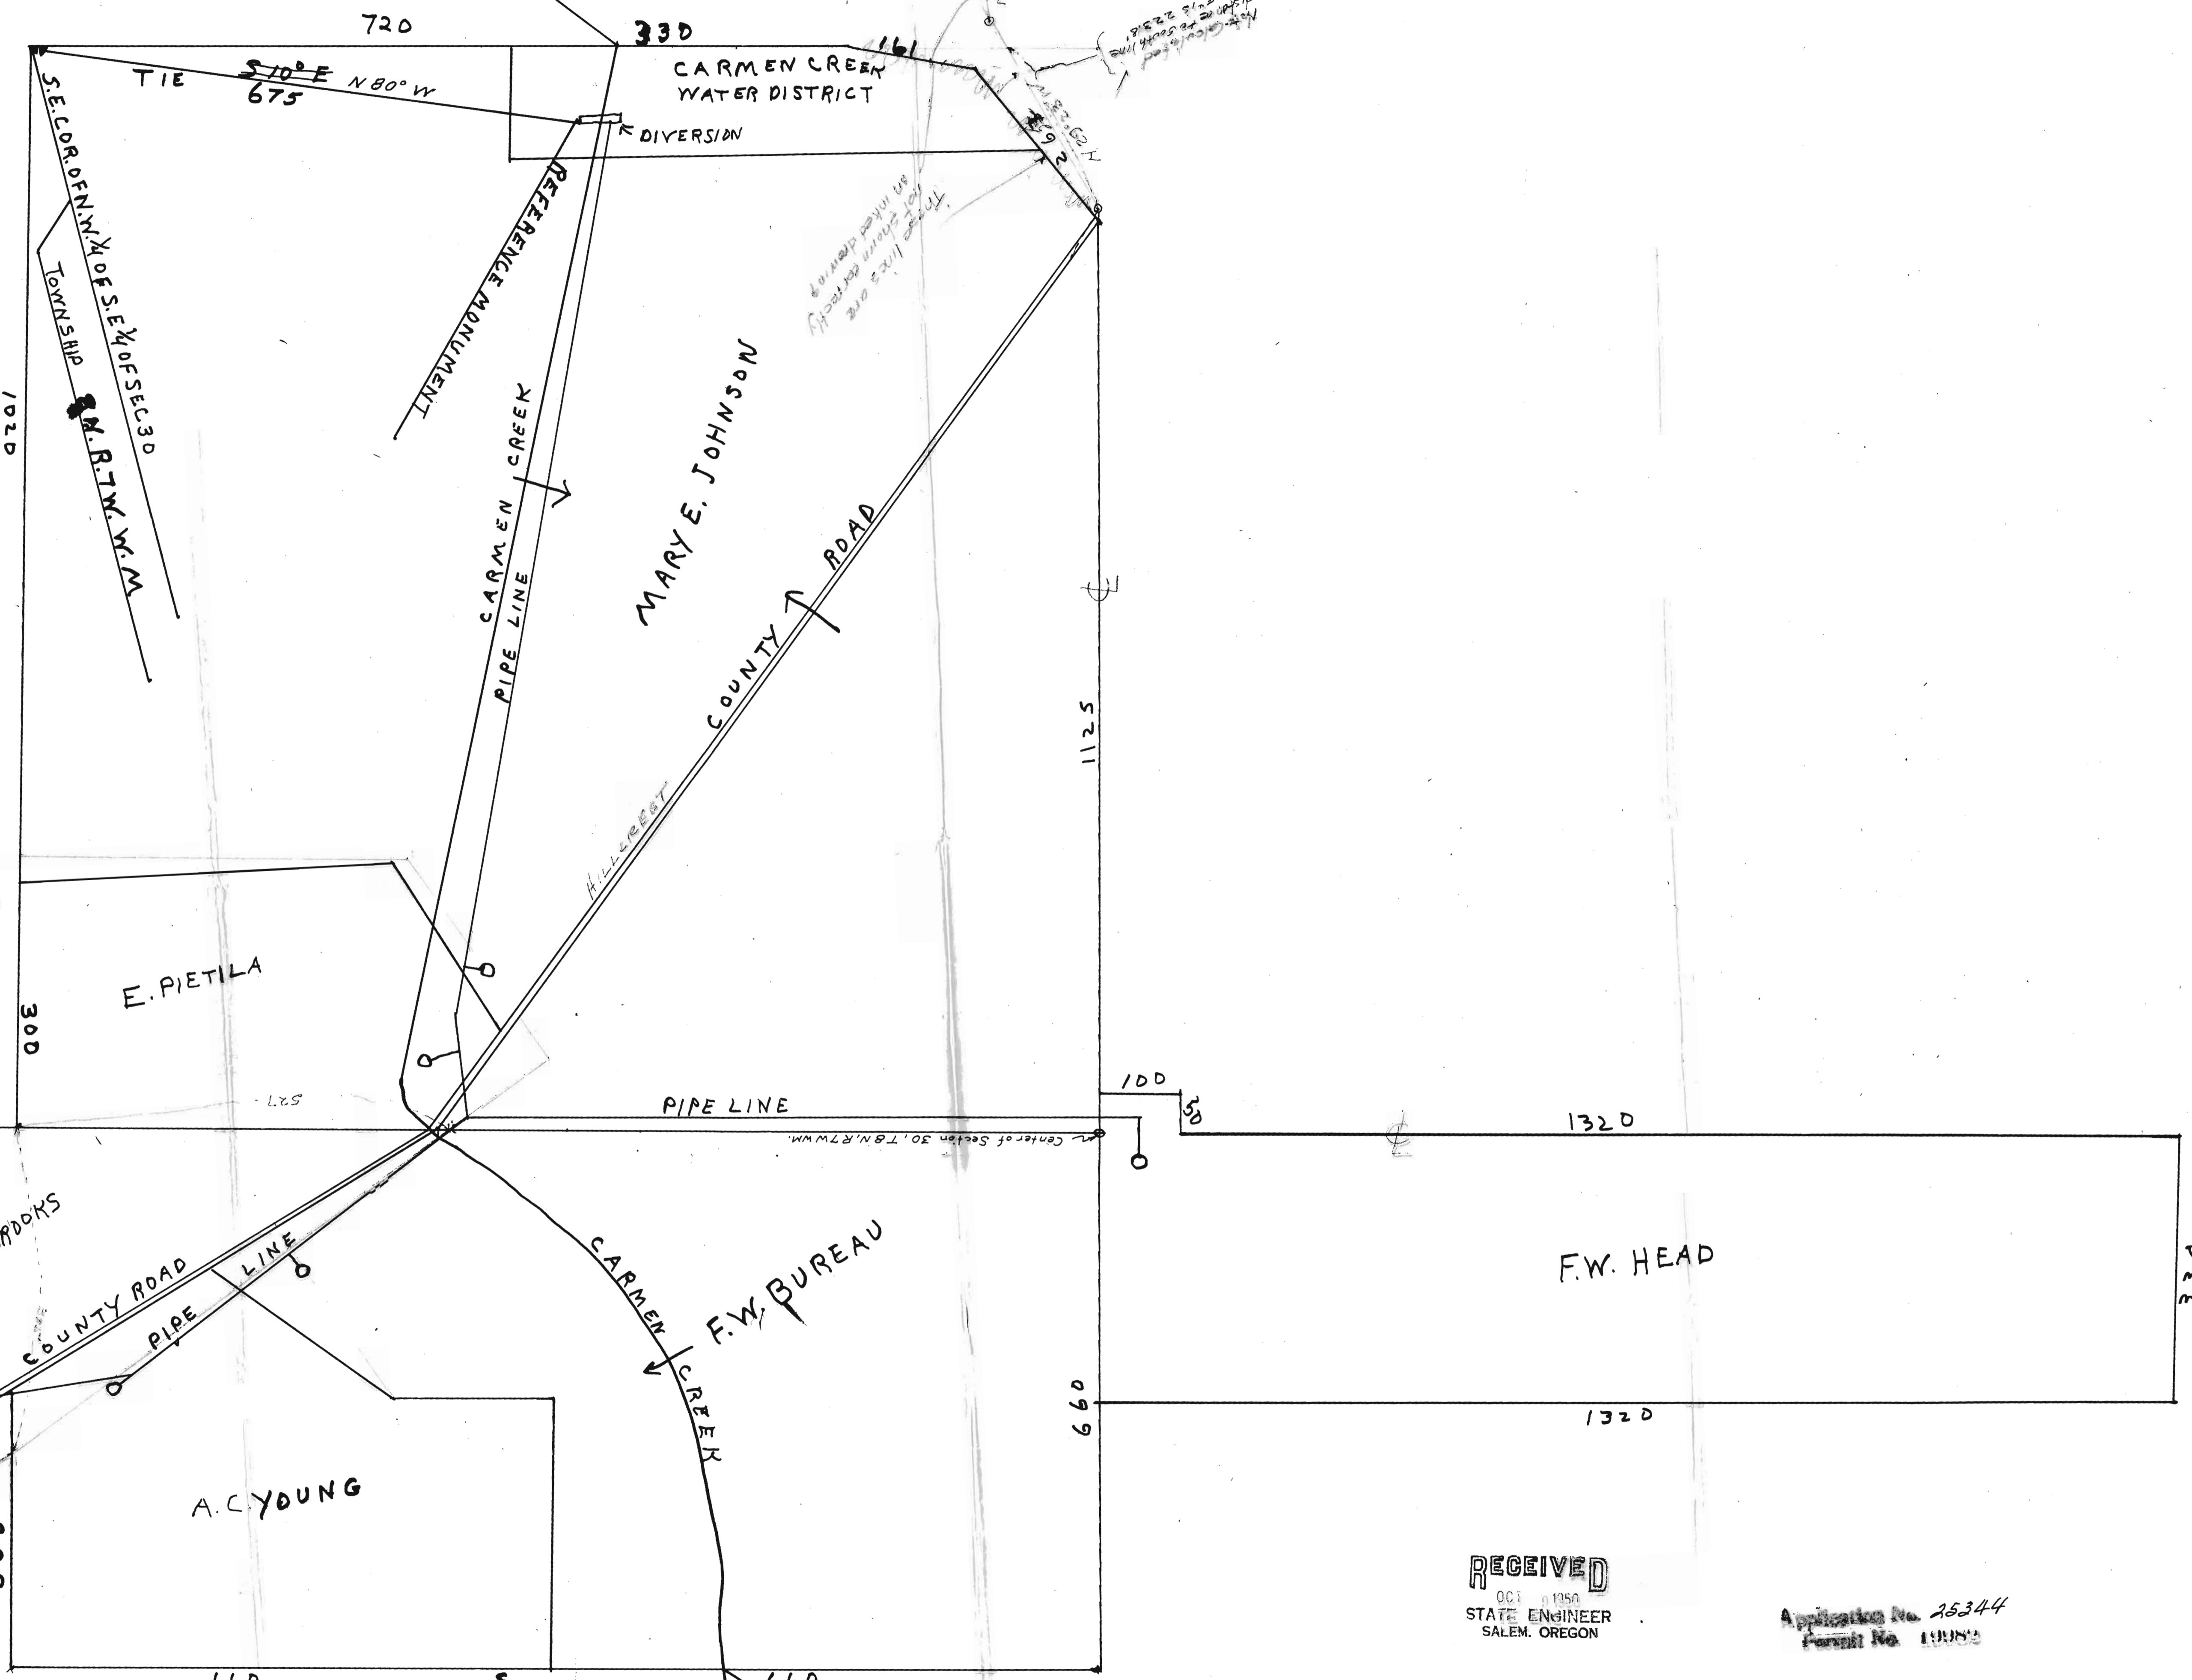


Not shown on map
district to south line
1/2 2.2 2.8'

These lines are
not shown on the
map of the district

RECEIVED
STATE ENGINEER
SALEM, OREGON

Application No. 25344
Permit No. 19882

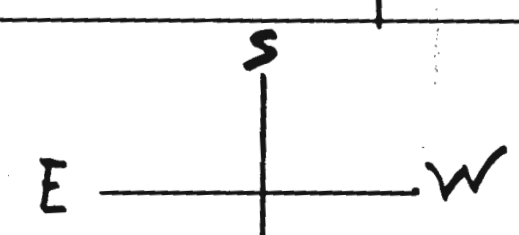

CARMEN CREEK OUTLET