


T.9.S., R.1.E. WM. Marion County Oregon.

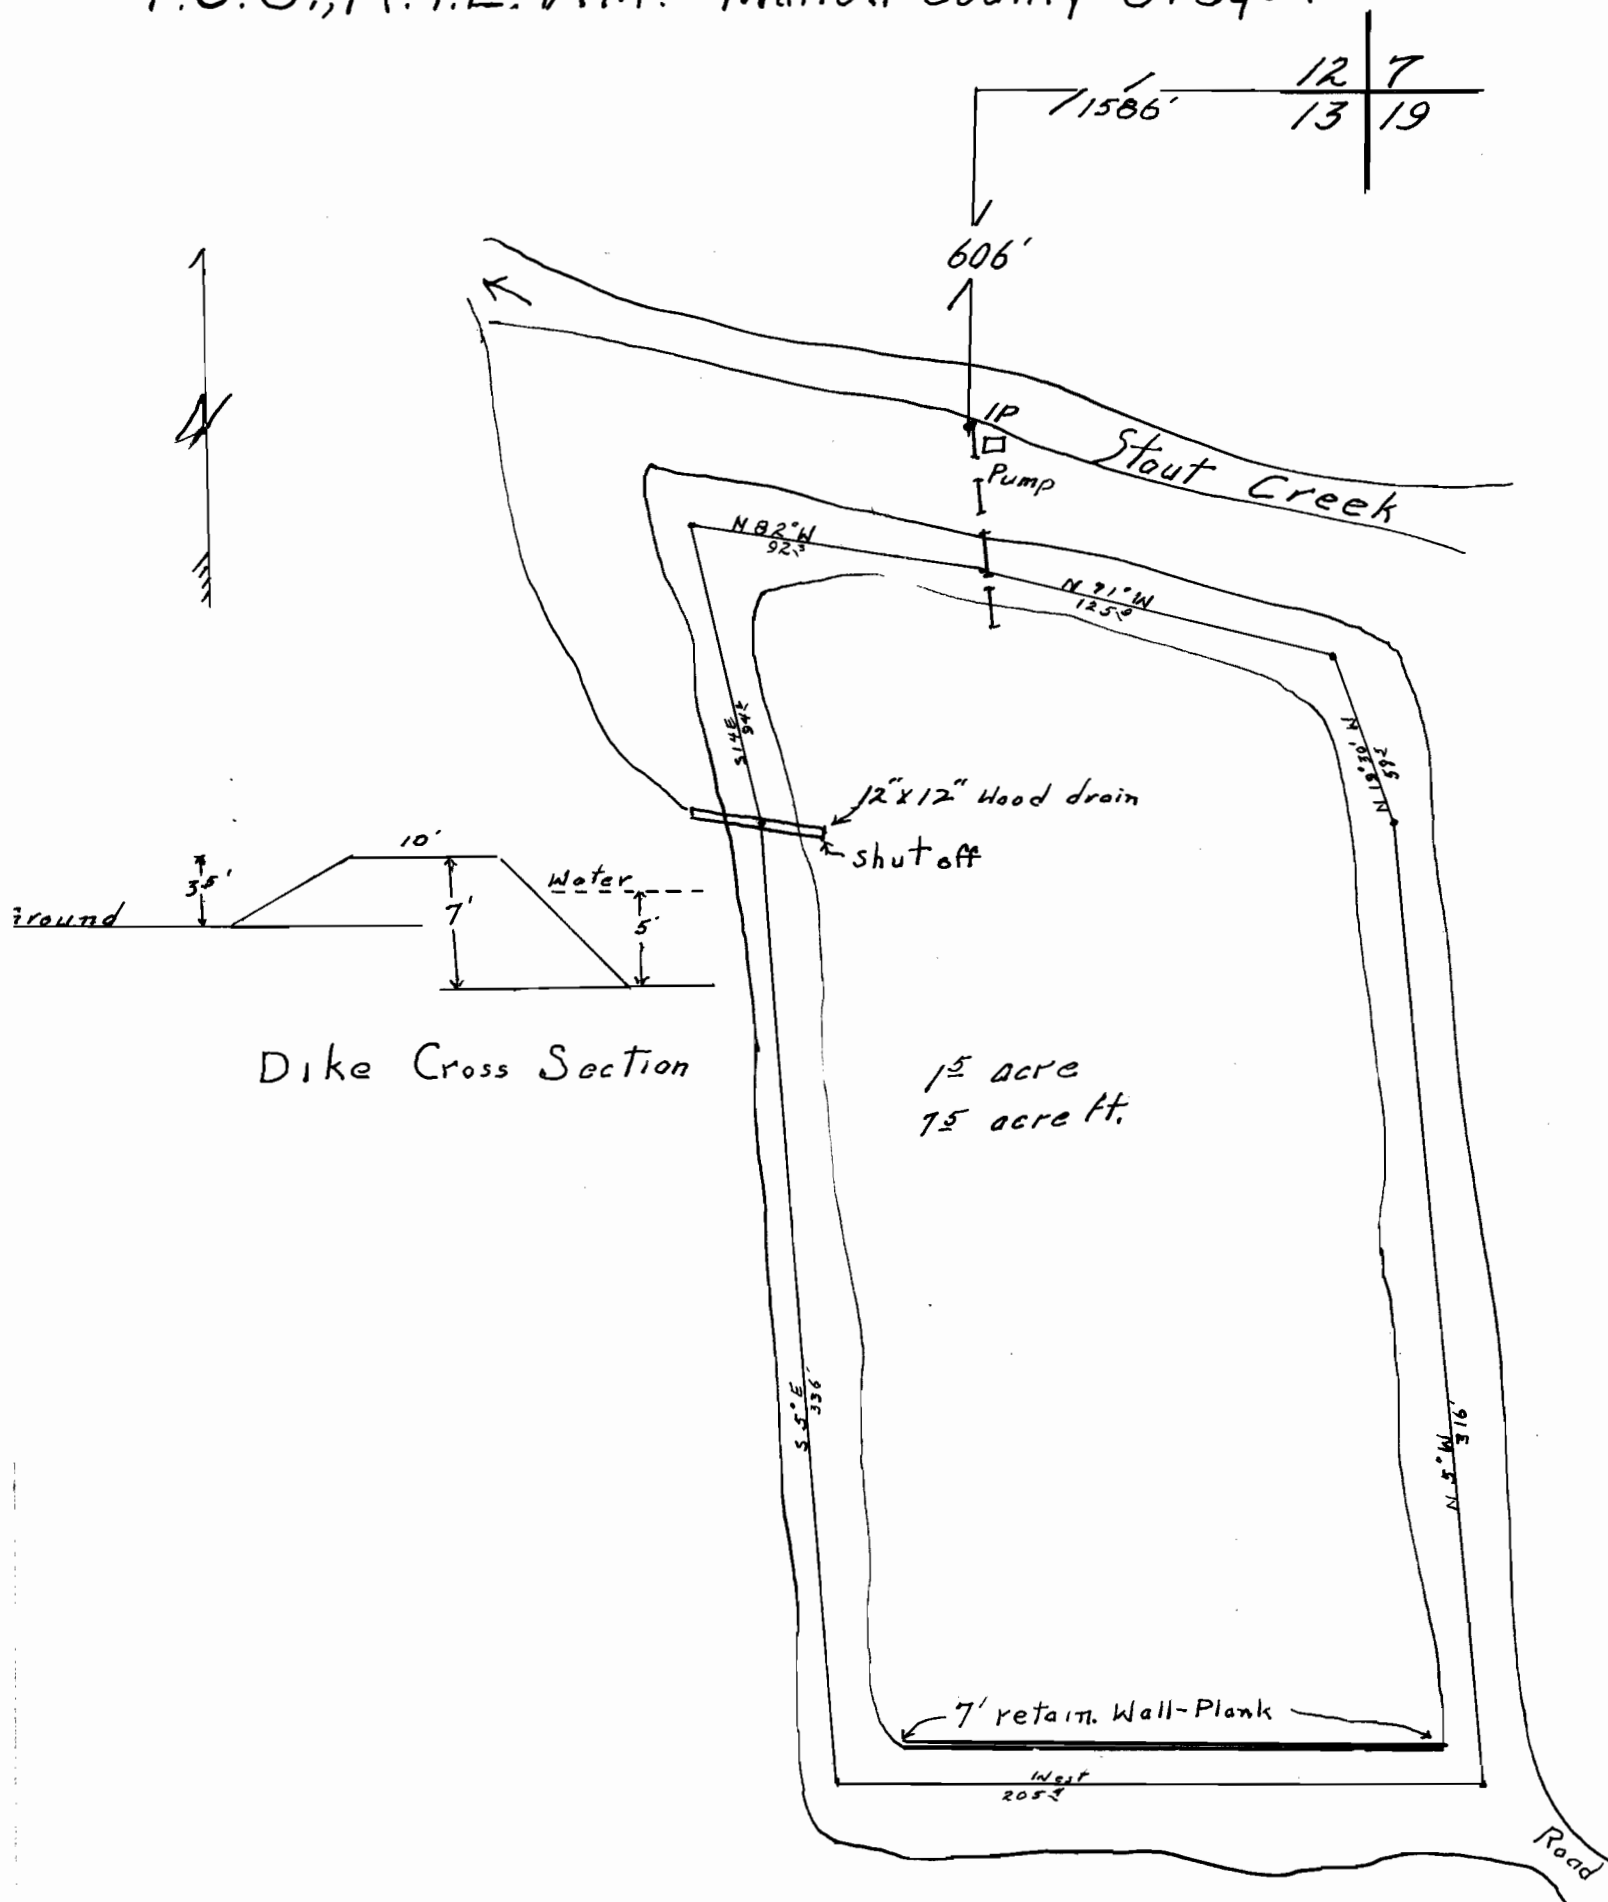

Application No. R-25364
Permit No. 25365
R-1103
19989