


RECEIVED
FEB 19 1951
STATE ENGINEER
SALEM OREGON

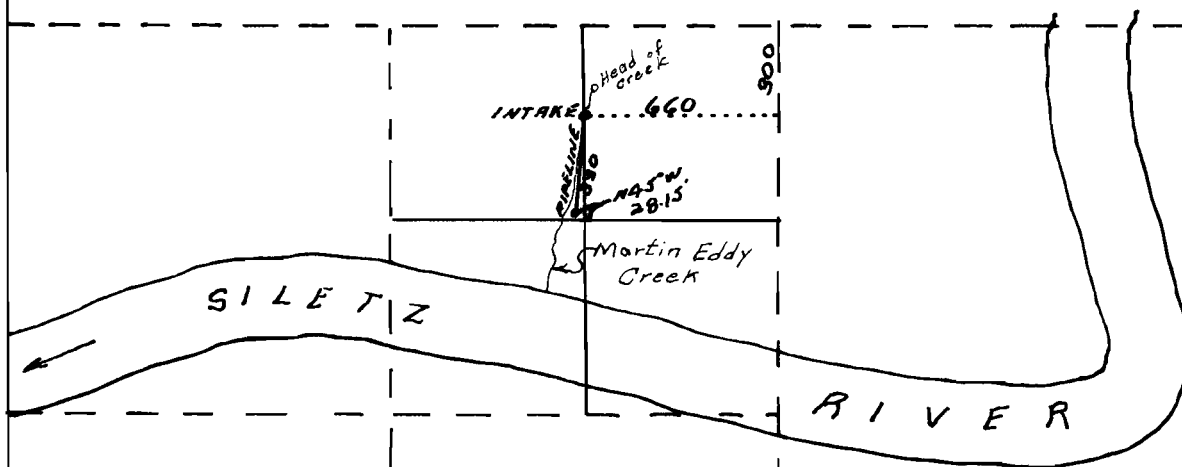

scale 1 mi = 8"



Application No. 25399
Permit No. 19997