

PLAT OF
 SECTIONS 29 & 30, T15R3W,
 showing
 LOCATION OF SPRING
 and
 PROPOSED PIPE LINE

scale - 2 in. = 1 mile.

April 4, 1914.

Tell Soule, Applicant.


RECORDED

APR 22 1914

SAWYER, OREGON

3580

2001

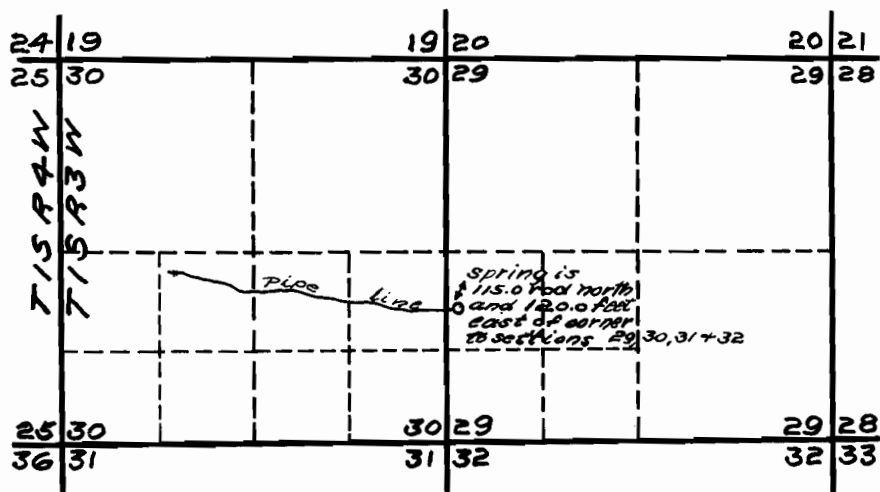

Revised map.