


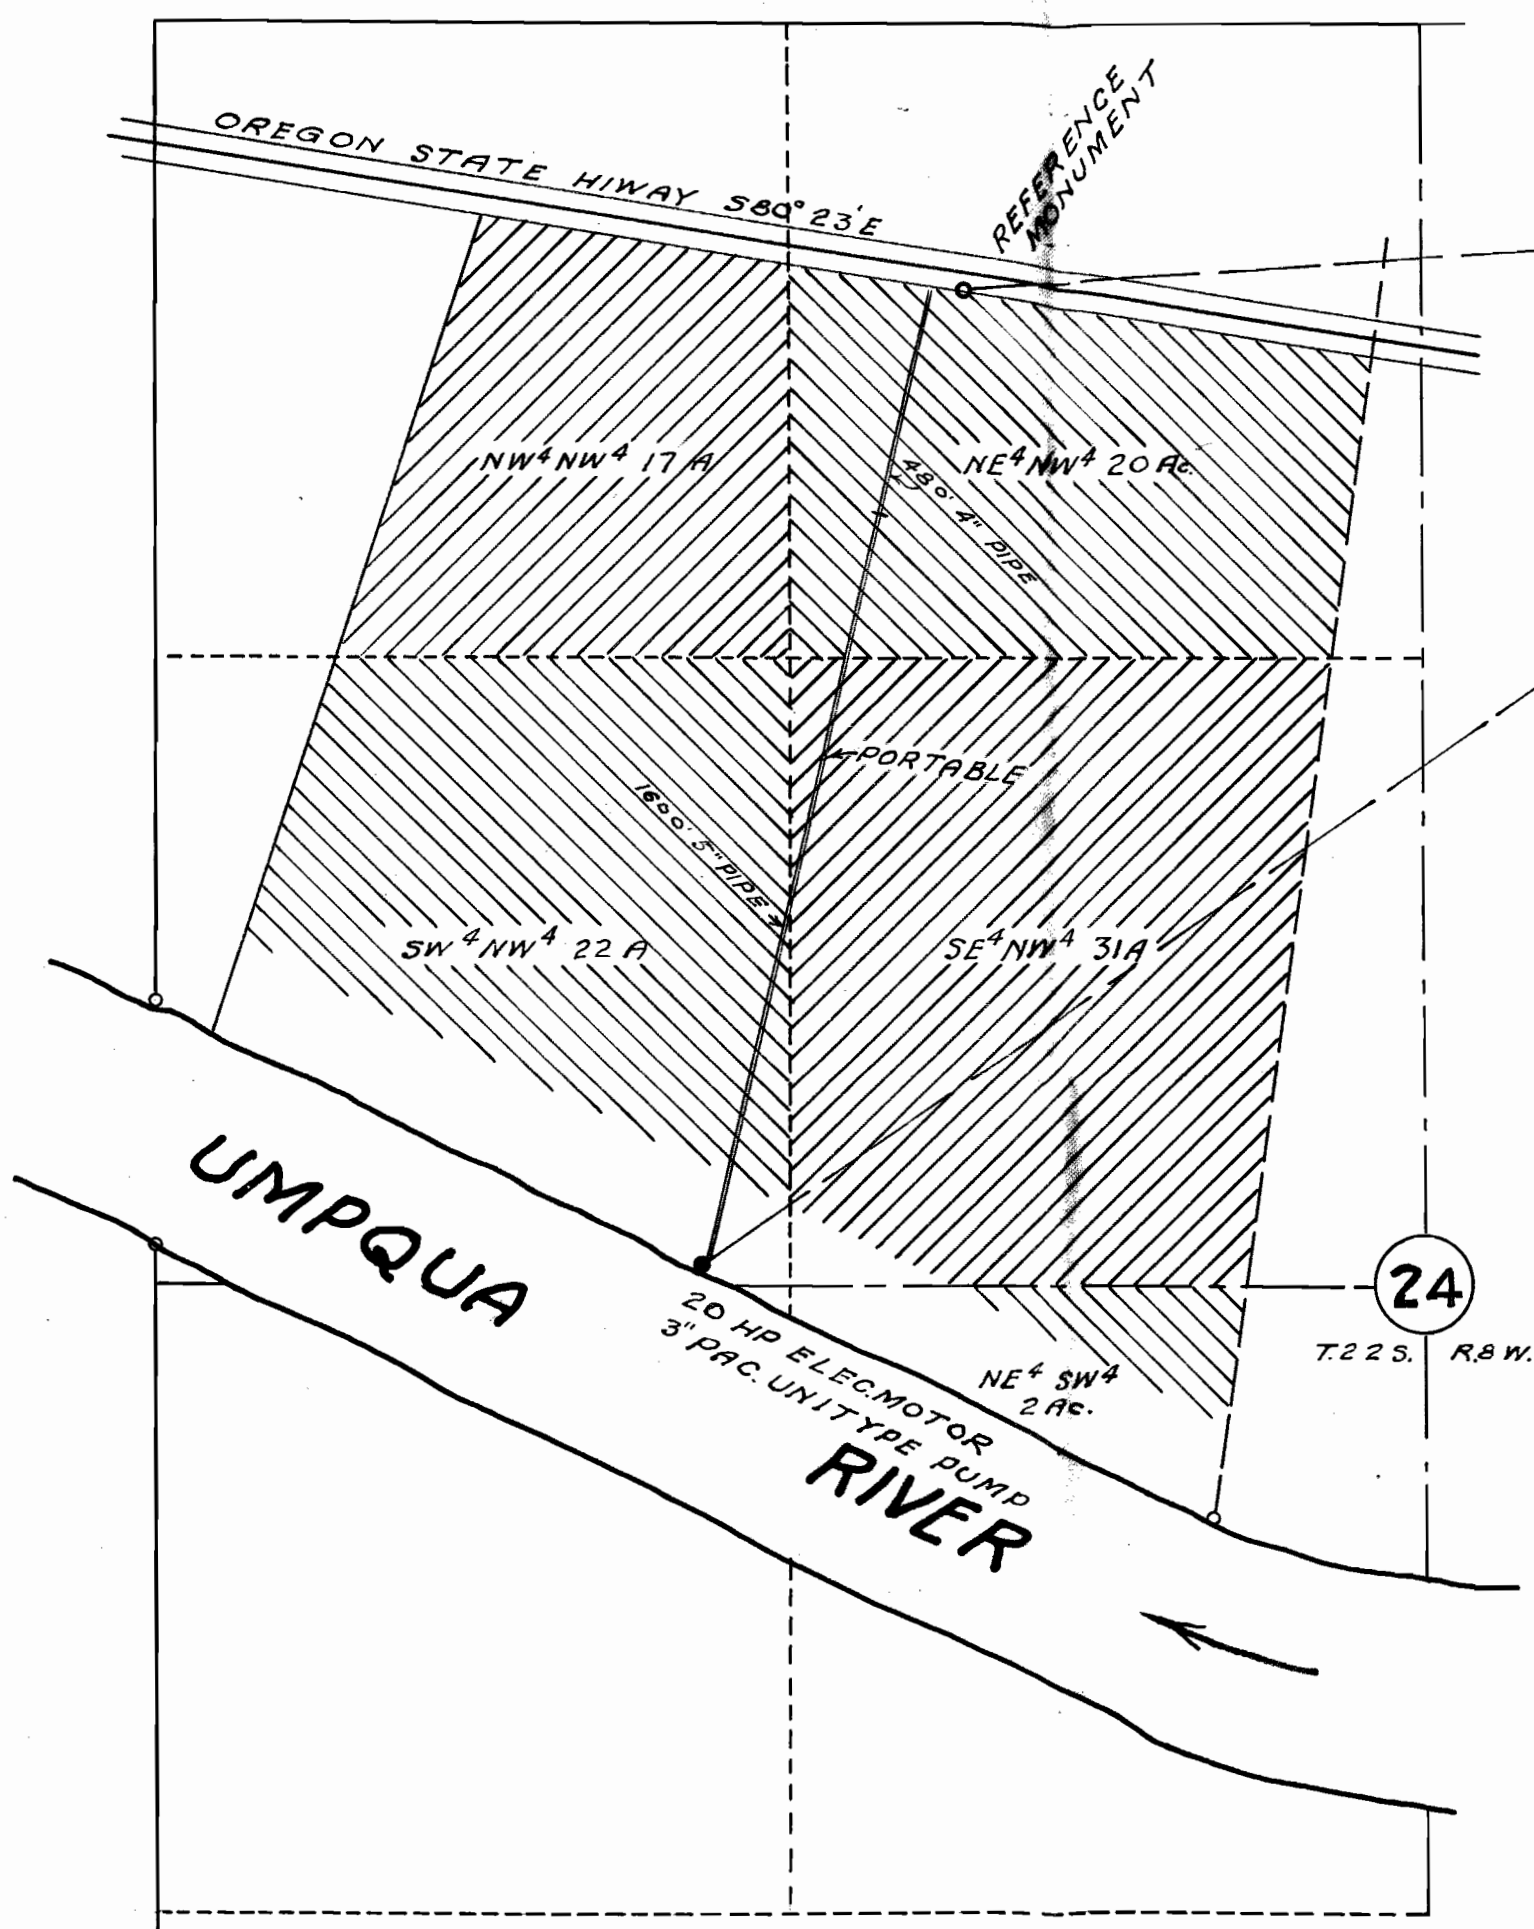

SW COR. WEST EXTEN.  
JOHN SCOTT DLC. #41

S 86° 38' W 2649.5

N 55° 15' E 3895.0

I, FRED L. DOW OF SUTHERLIN, OREGON DO  
HEREBY CERTIFY THAT THIS MAP WAS MADE  
FROM NOTES TAKEN DURING AN ACTUAL  
SURVEY MADE BY ME ON NOV. 29, 1950 AND  
THAT THE MONUMENT SHOWN ON THIS MAP  
CONSISTING OF A 1" X 36" IRON PIPE IS SOUTH  
86° 38' W 2649.4 FEET FROM THE S.W. CORNER  
OF THE WEST EXTENSION OF THE JOHN  
SCOTT DLC. No. 41 IN SEC. 24, T. 22 S. R. 8 W. W.M.

*Fred L. Dow*



RECEIVED

**FRANK W. BINDER**  
**ELKTON ORE**

SCALE 1"=400'

Application No. 25549  
Permit No. 20062