


P. W. GEORGE OAKLAND—OREGON

RECEIVED

MAR 12 1951
STATE ENGINEER
SALEM, OREGON

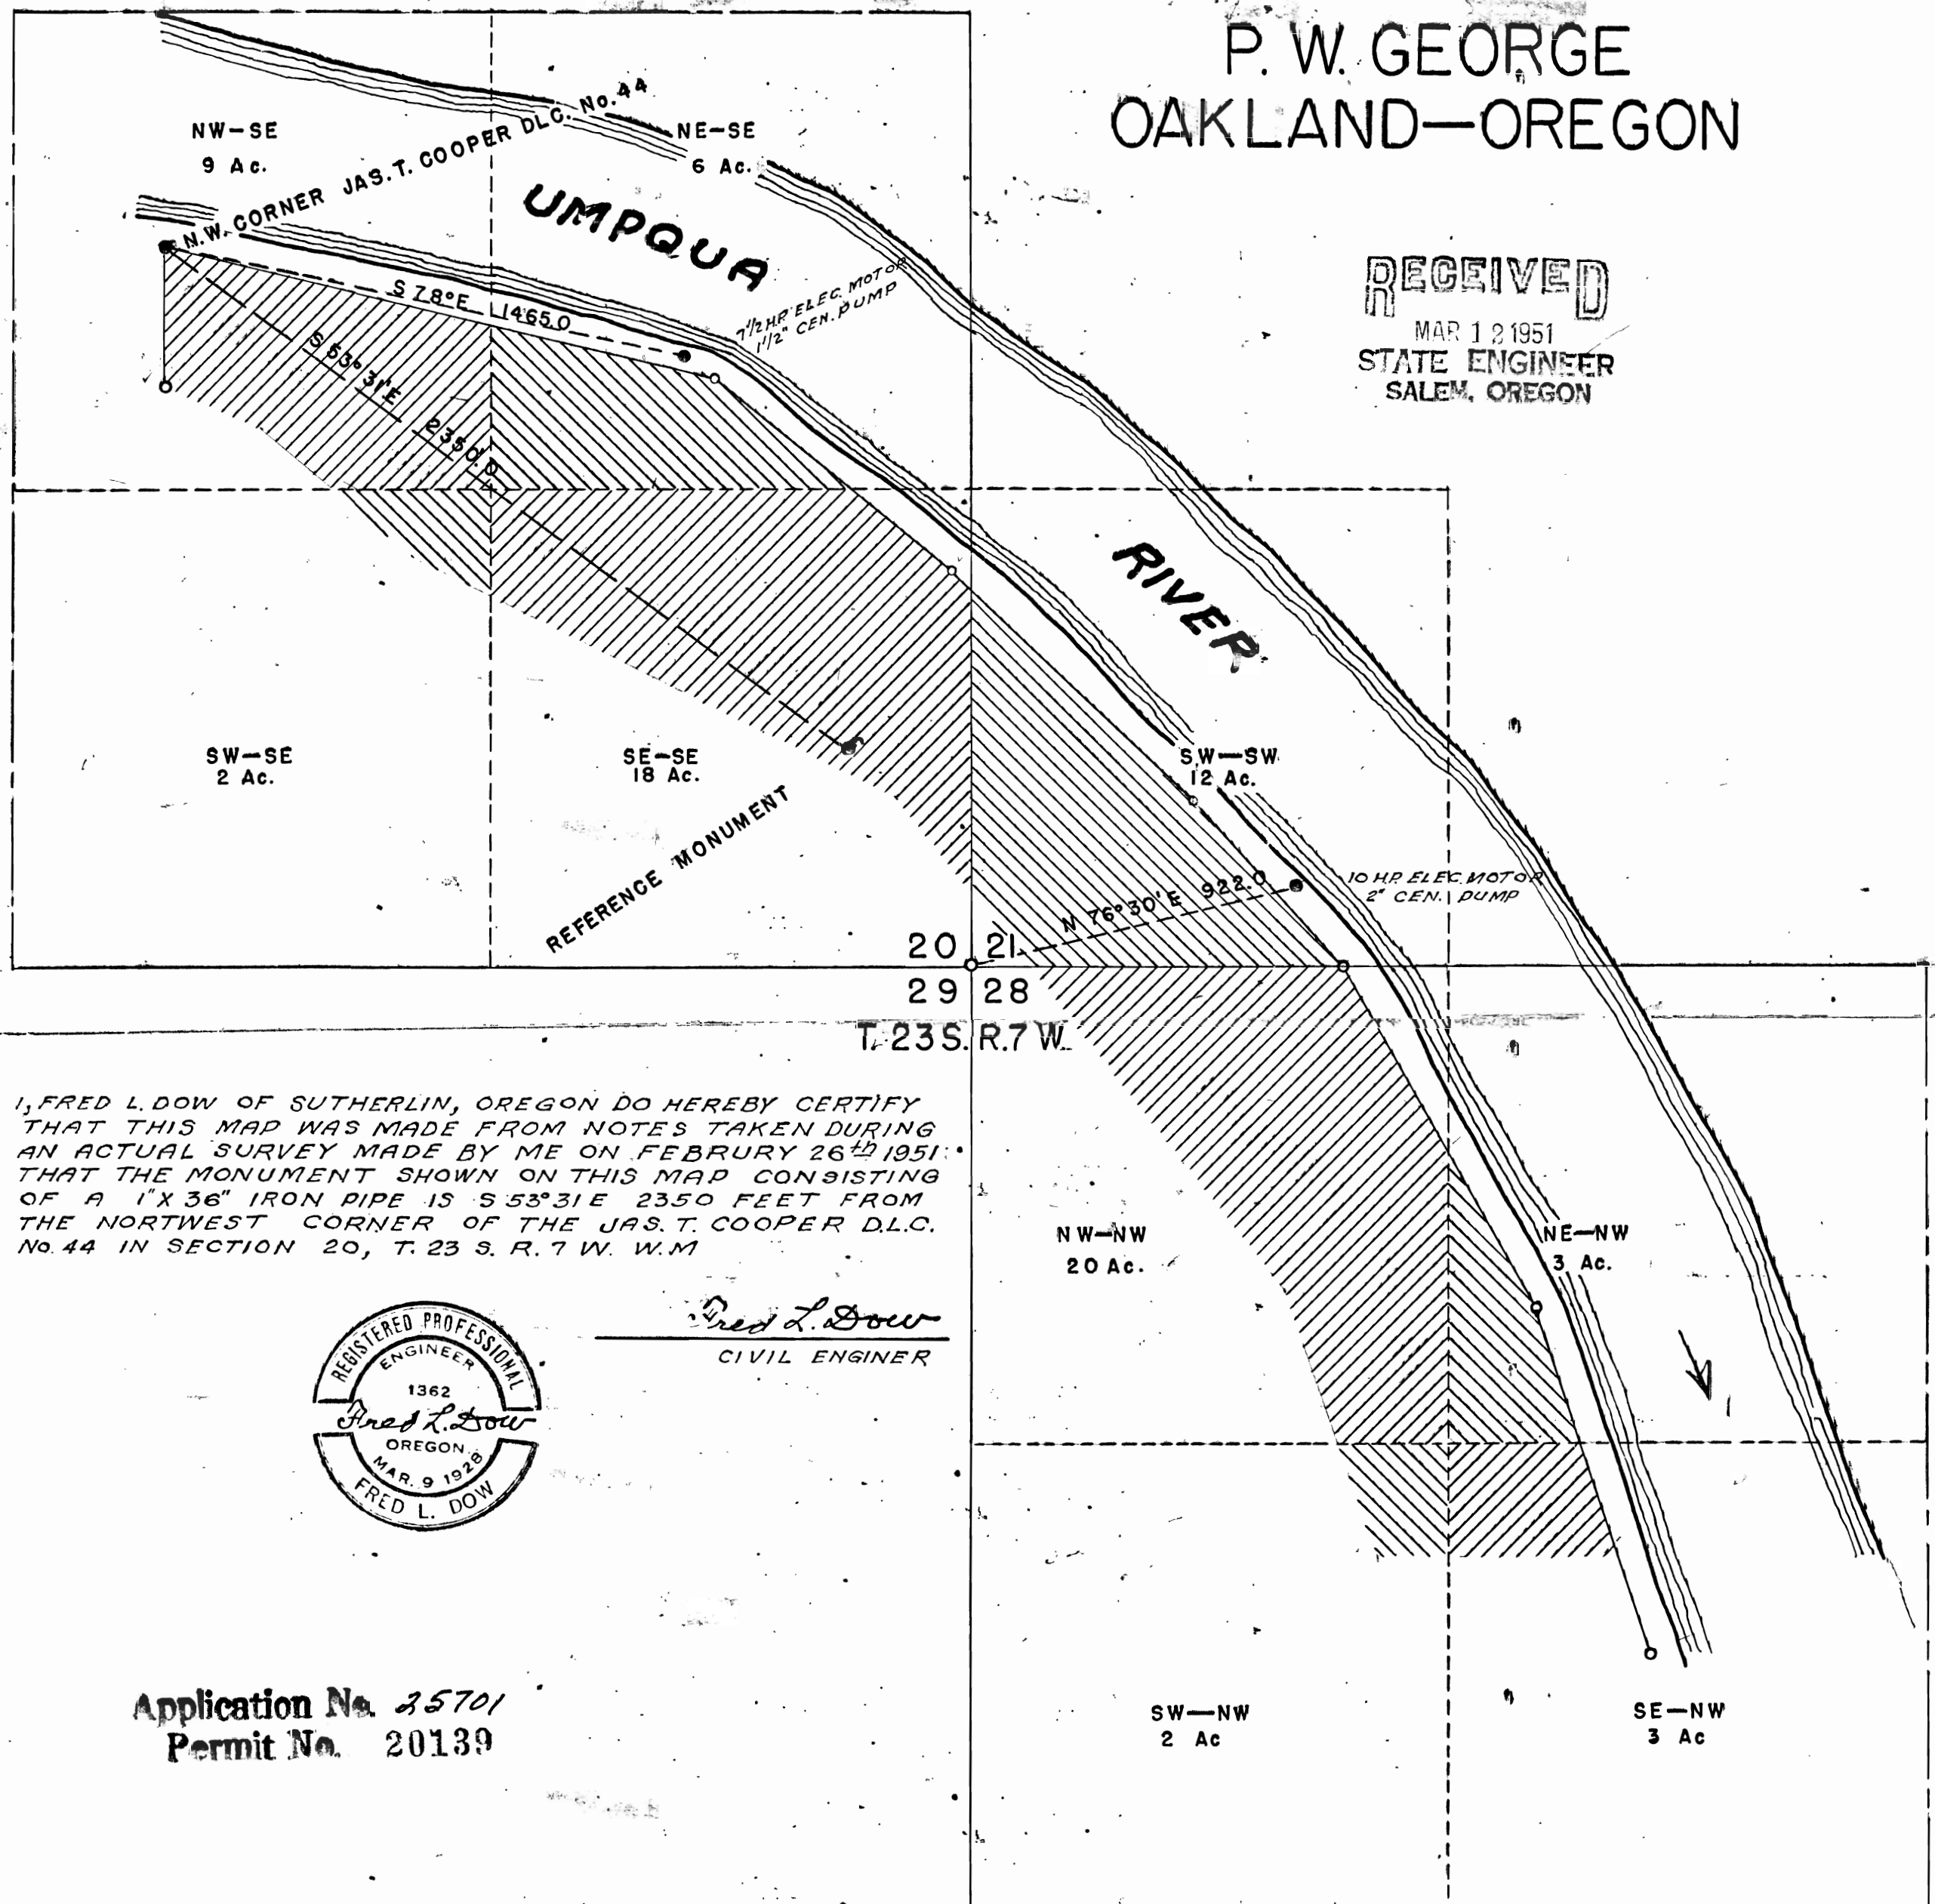

I, FRED L. DOW OF SUTHERLIN, OREGON DO HEREBY CERTIFY
THAT THIS MAP WAS MADE FROM NOTES TAKEN DURING
AN ACTUAL SURVEY MADE BY ME ON FEBRUARY 26th 1951.
THAT THE MONUMENT SHOWN ON THIS MAP CONSISTING
OF A 1" X 36" IRON PIPE IS S 53° 31' E 2350 FEET FROM
THE NORTHWEST CORNER OF THE JAS. T. COOPER D.L.C.
No. 44 IN SECTION 20, T. 23 S. R. 7 W. W.M



Fred L. Dow
CIVIL ENGINEER

Application No. 25701
Permit No. 20139