


SEC. 13, T. 36 S., R. 2 W. W. M.

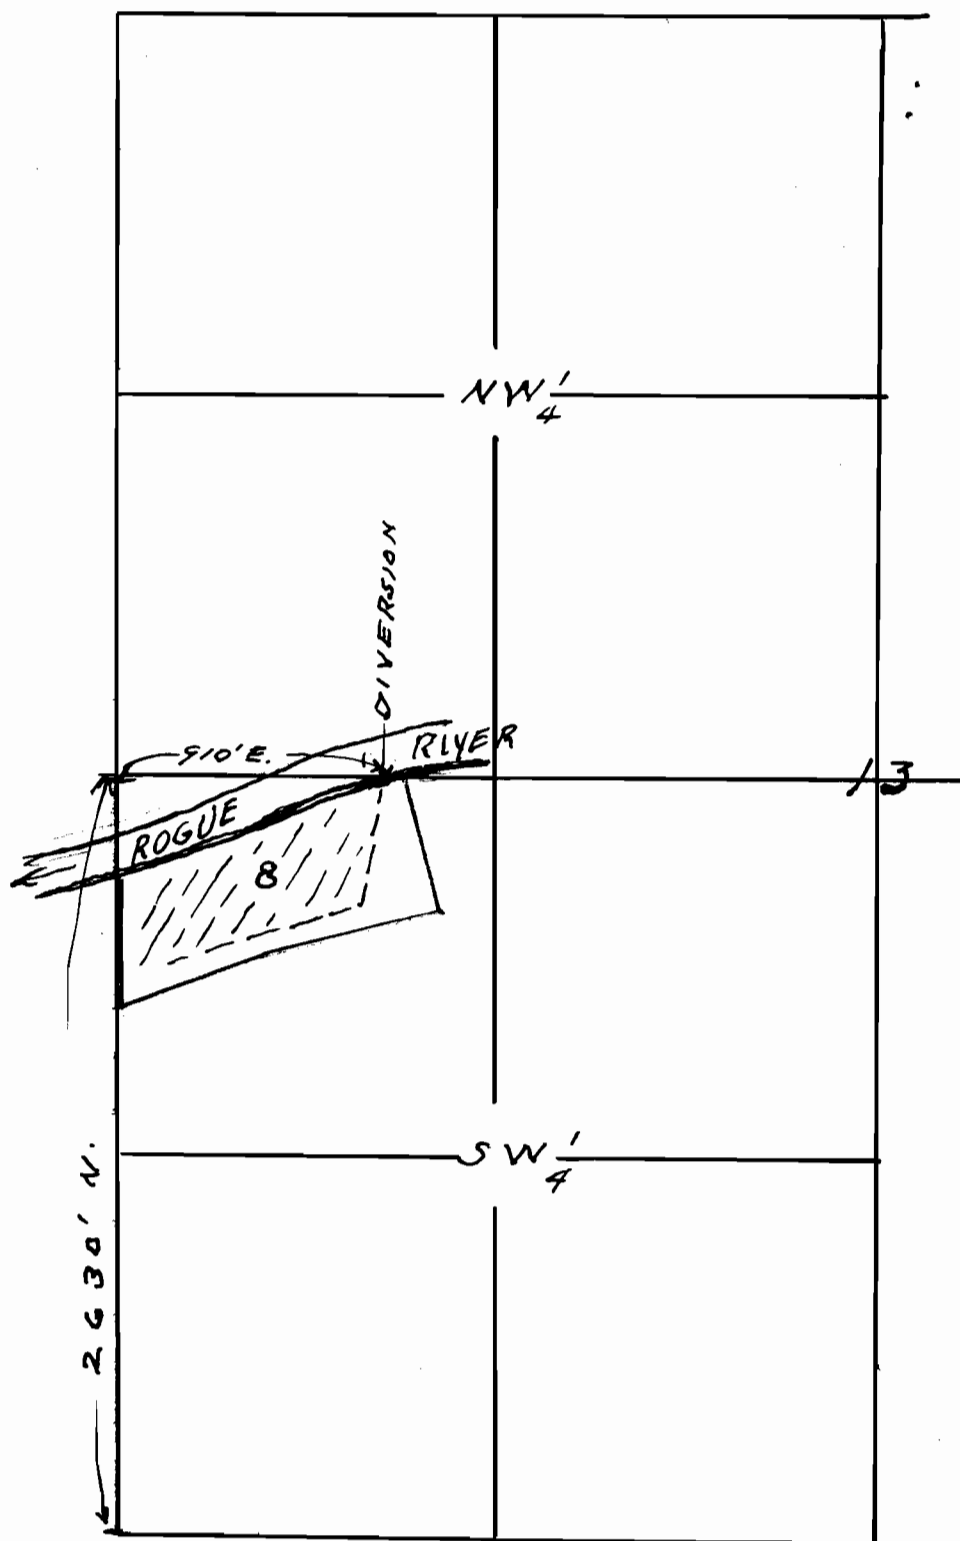

Map To accompany application of
L.W. Milbourn for use of water
from Rogue River for irrigation.

Application No. 25773
Permit No. 20159

This office 3/31/51 *[Signature]*