


T. 16S. R. 19E. W.M.

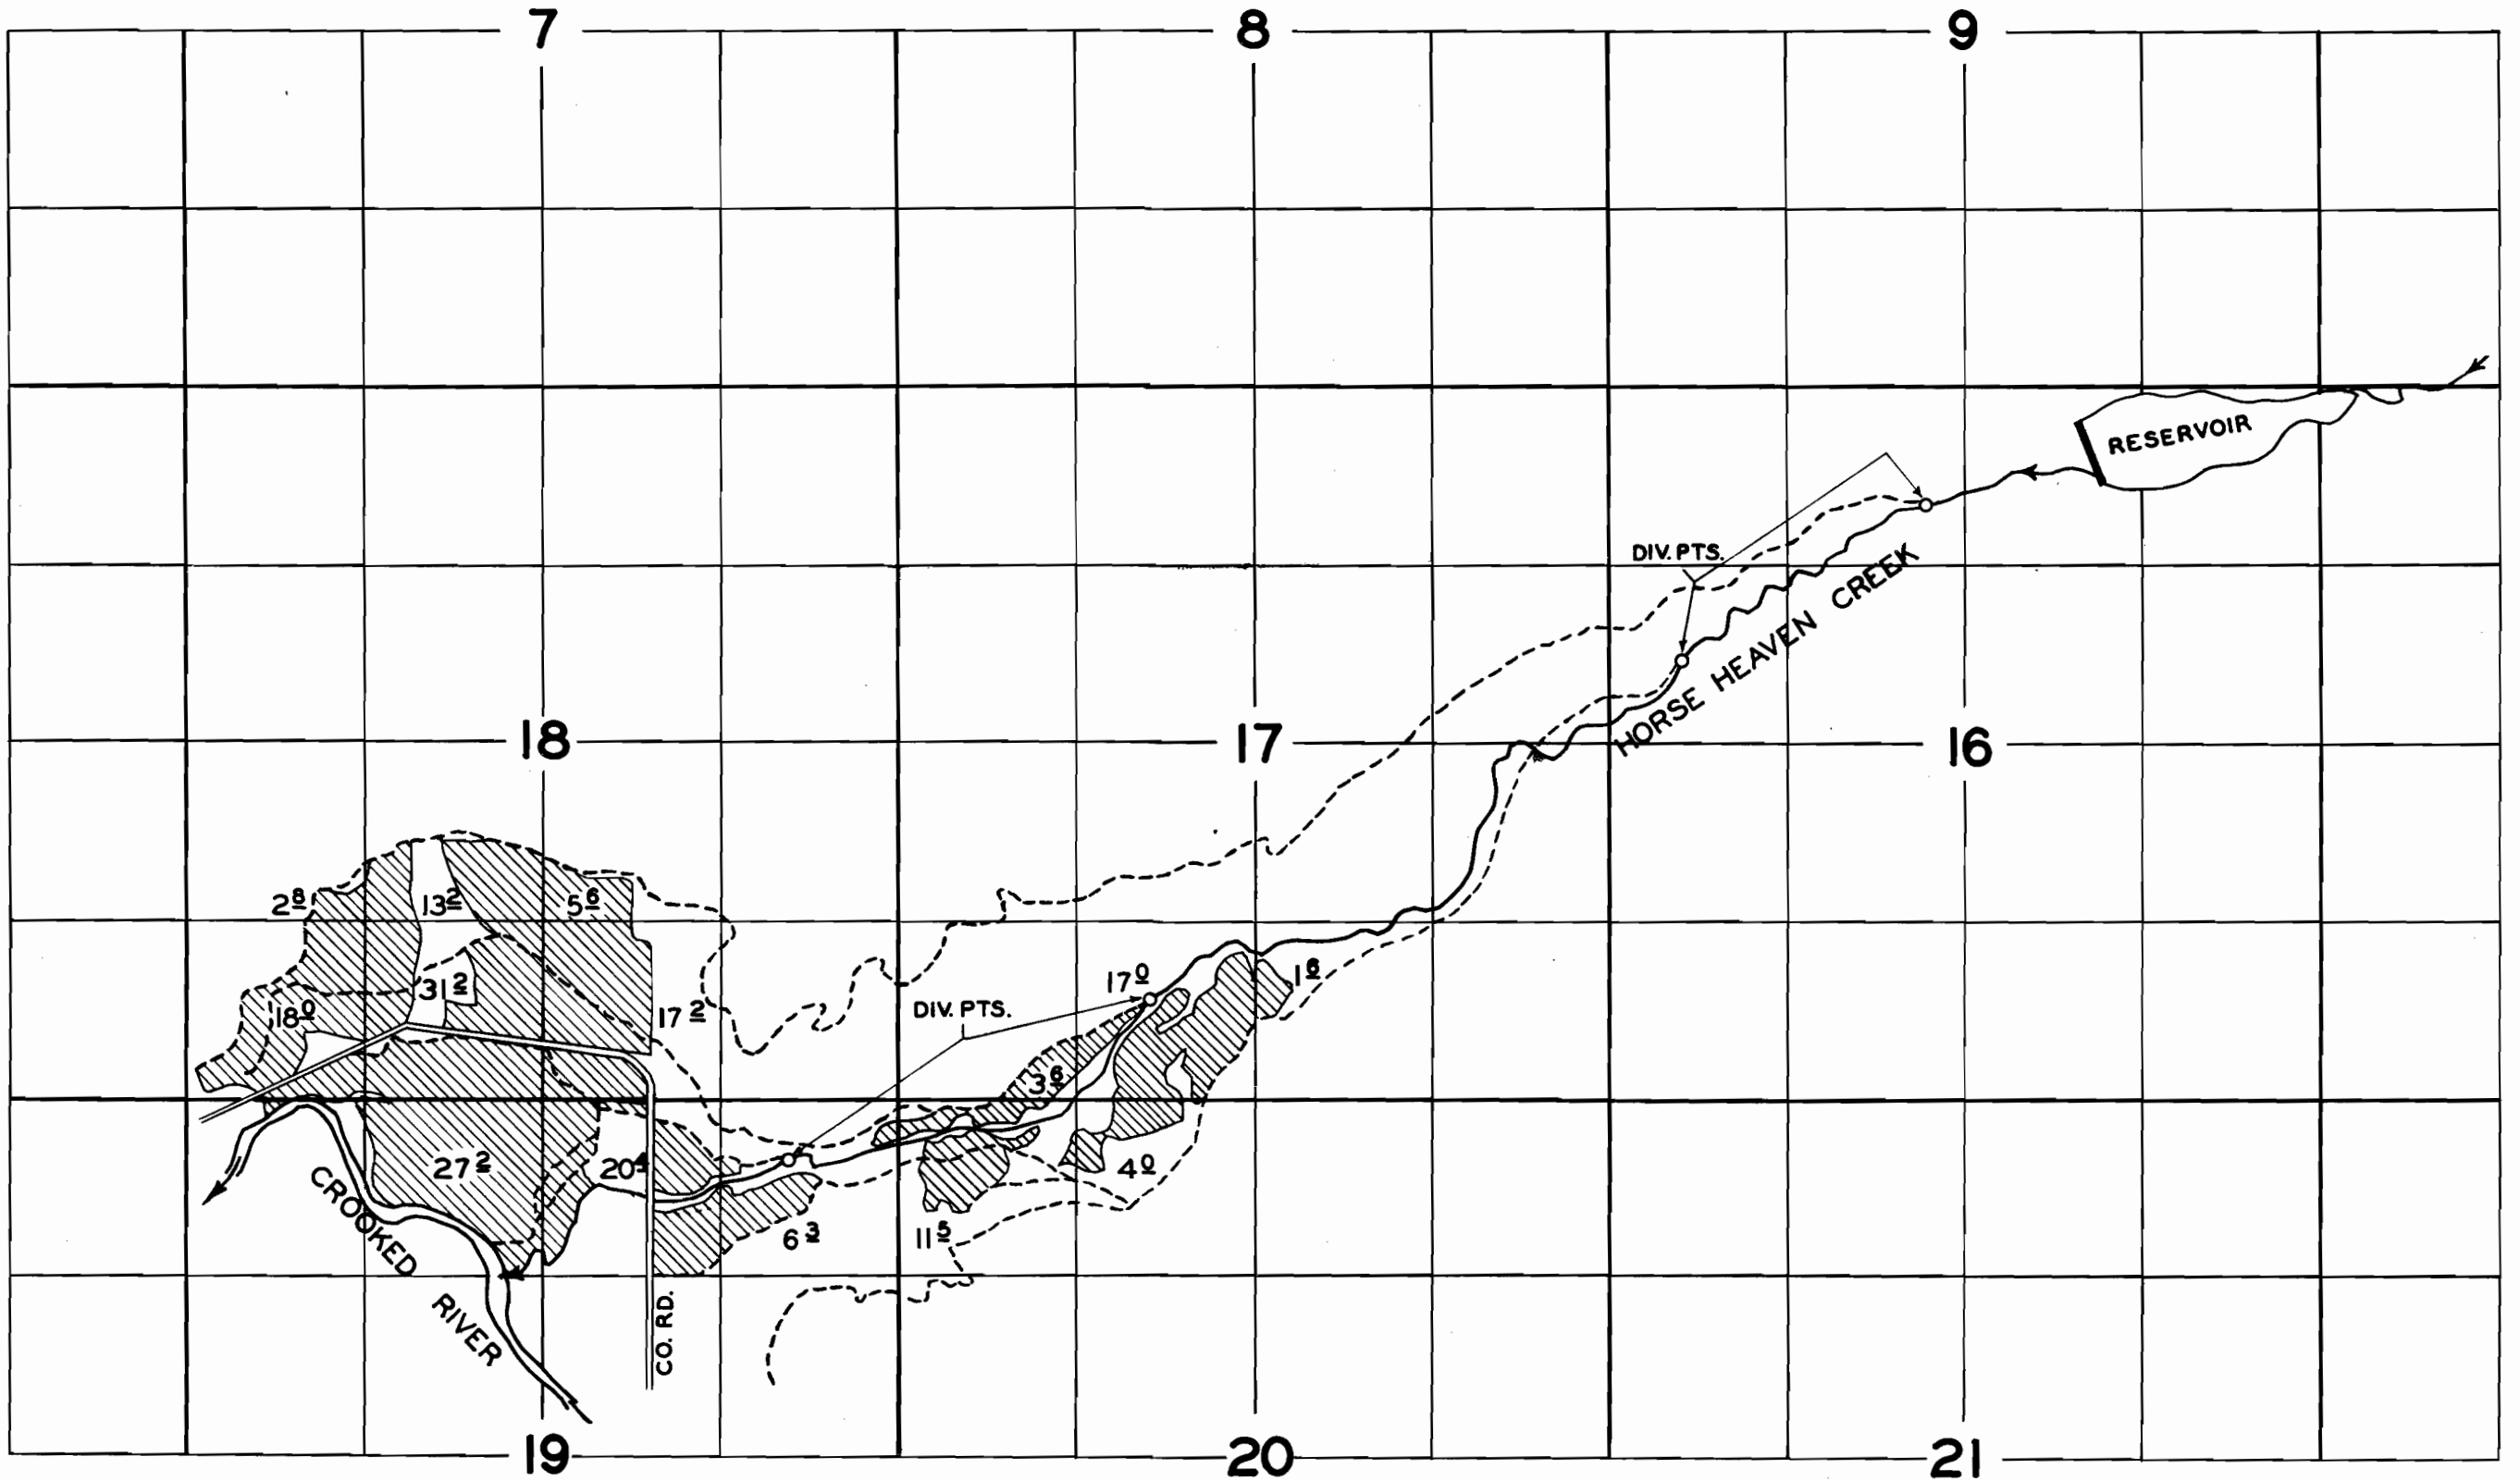

FINAL PROOF SURVEY

UNDER
R-24957 R-1130
Application No. 24958 Permit No. 20200

IN NAME OF

Hudspeth Land & Livestock Co.

Surveyed AUG. 7, 1957, by C.D. Bristola


RECEIVED
STATE ENGINEER

MAP

TO ACCOMPANY APPLICATION FOR PERMIT
TO APPROPRIATE WATER

SCALE: 2" = 1 MILE.

FRED W. WICKMAN - OWNER.

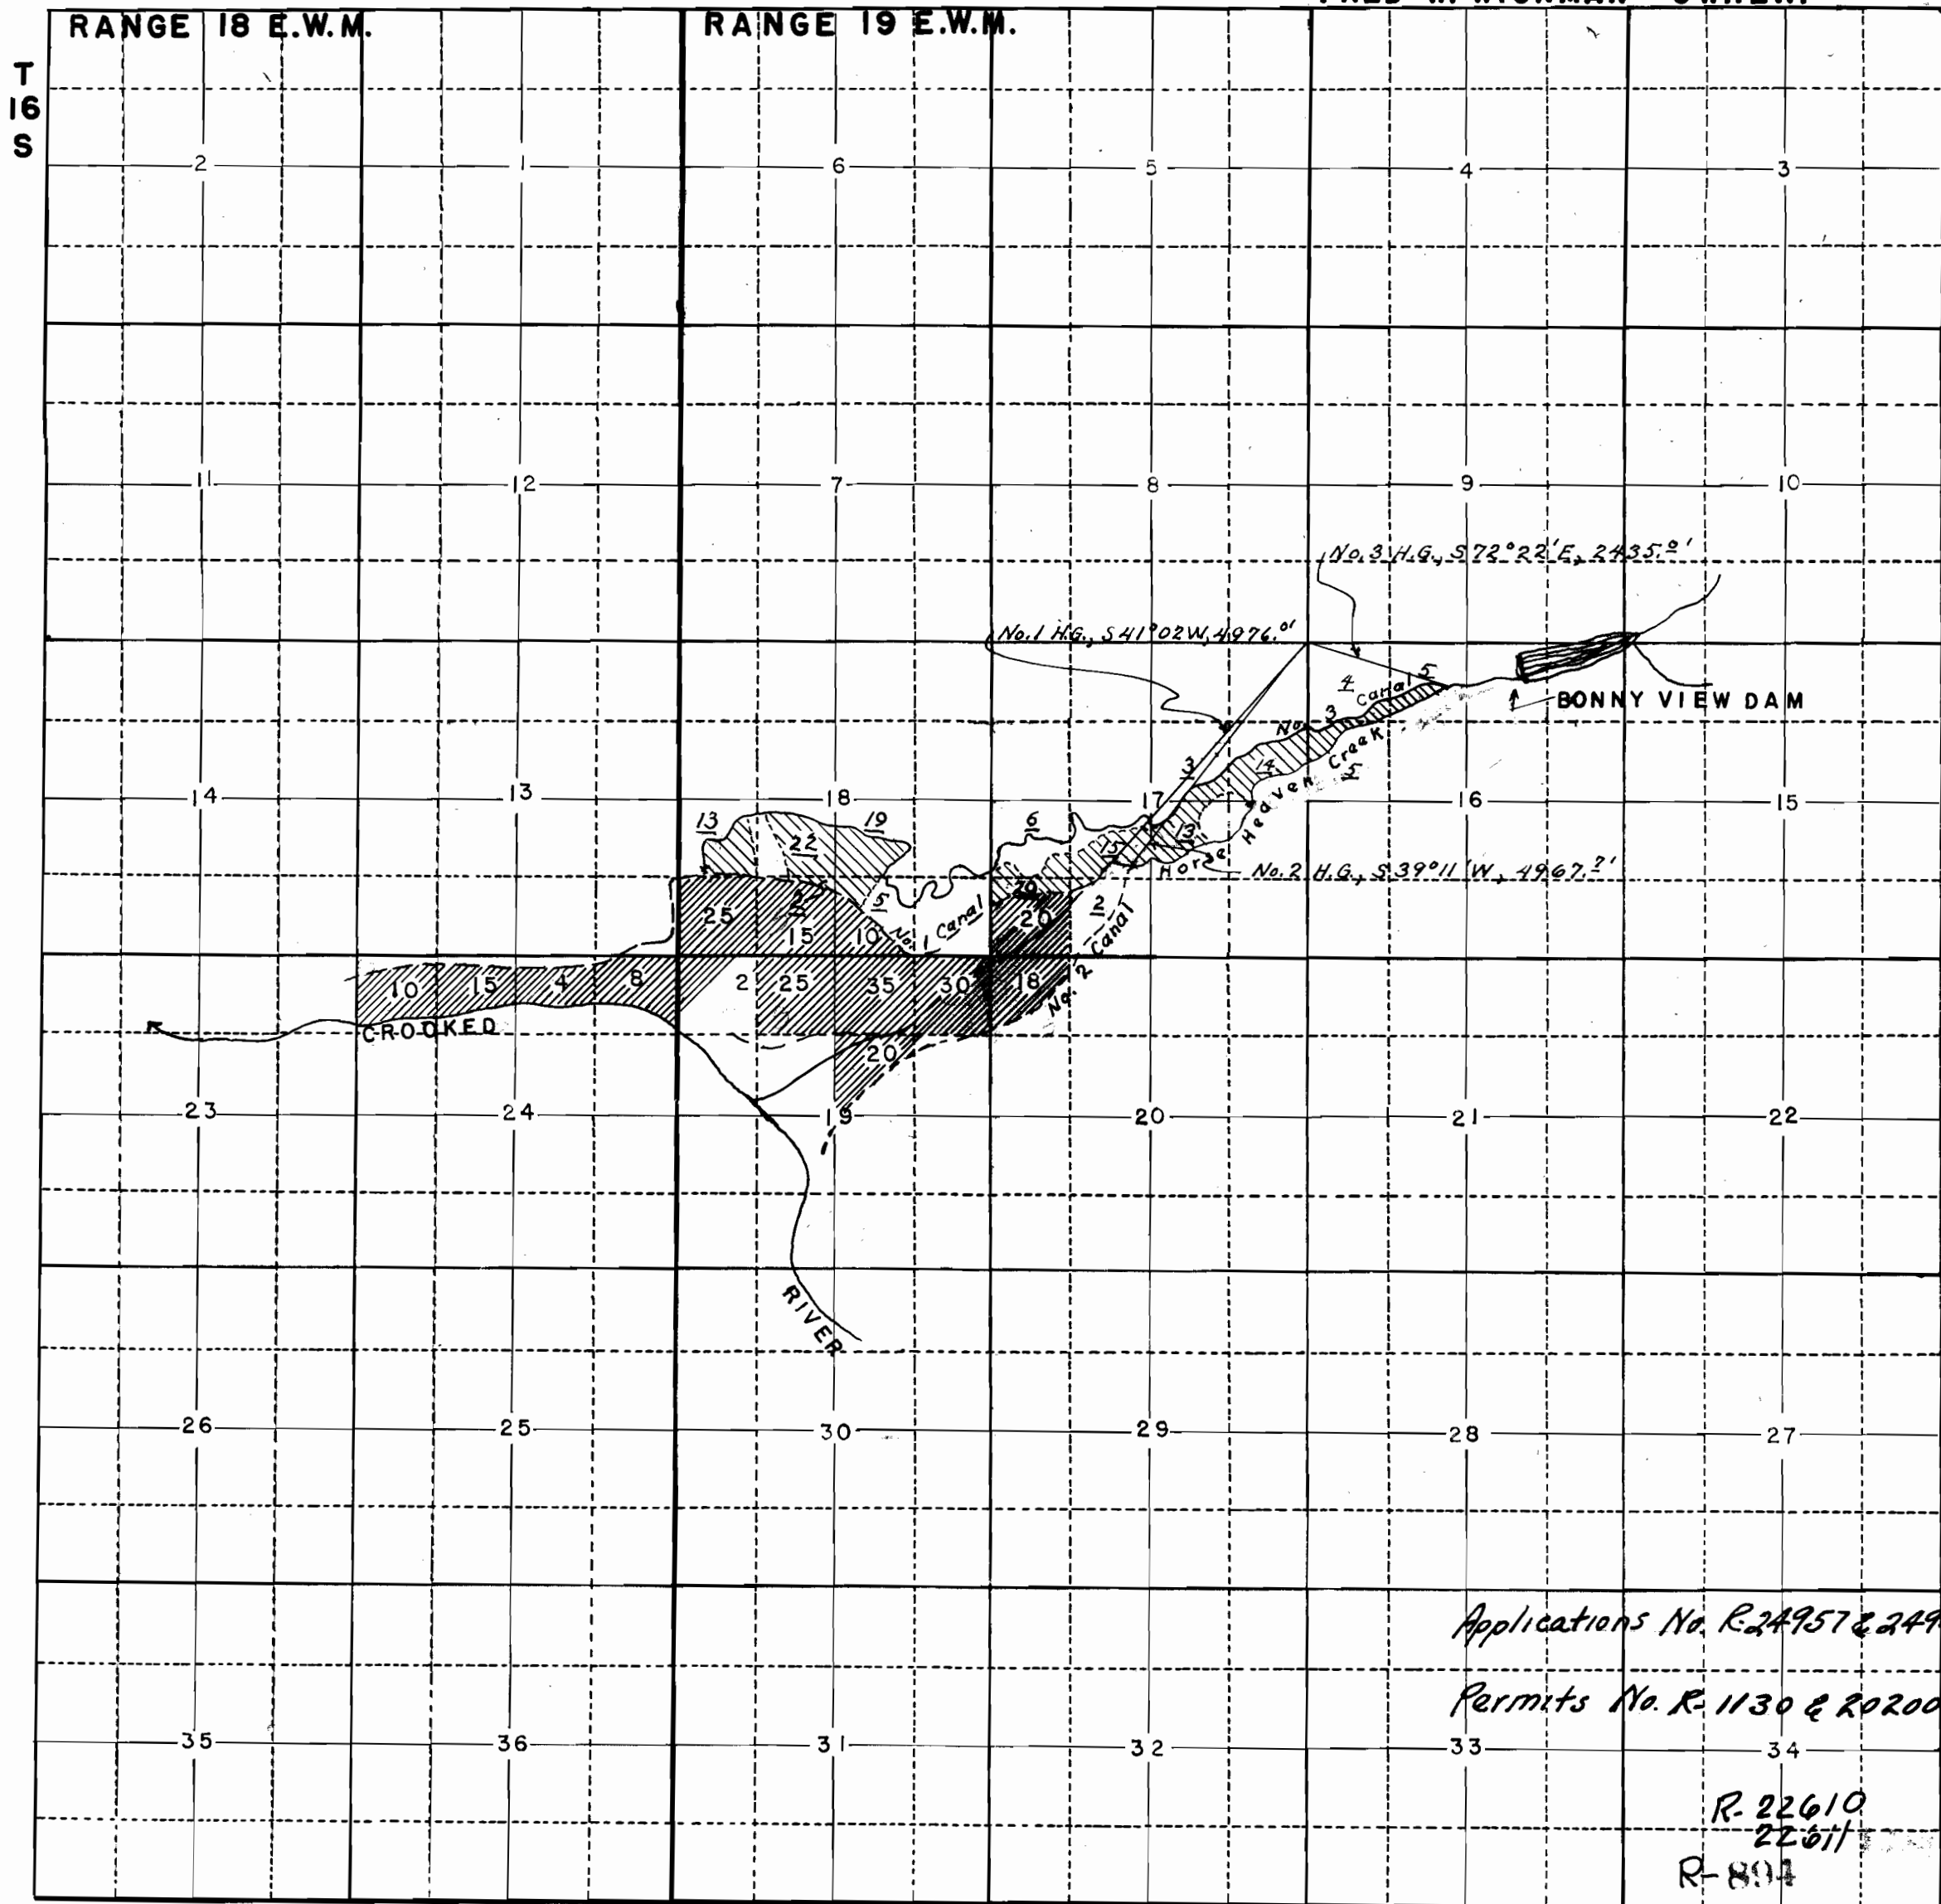

Applications No. R-24957 & 24958


R-22610
22611
R-894