


T. 36 S., R. 4 W., W. M.

Scale 100' = 1"

March 1951

A. G. Wilson.

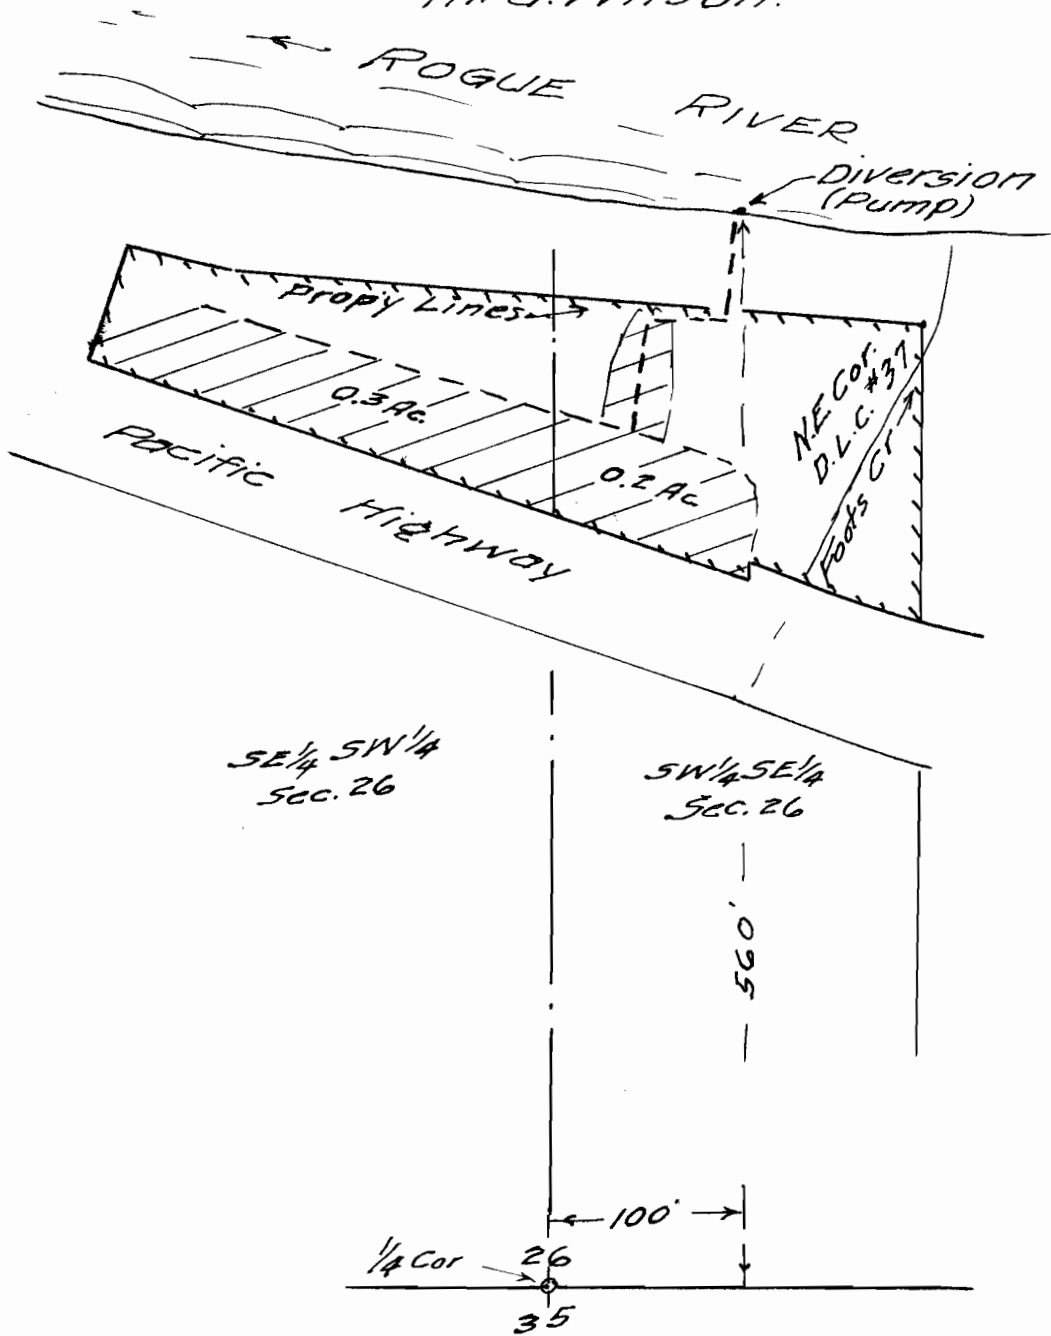

Application No. 25722

Permit No. 20-59

RECEIVED
 STATE ENGINEER
 SALEM, OREGON

55112 15 670