


Sec. 14, T. 32 S., R. 1 E. W.M.

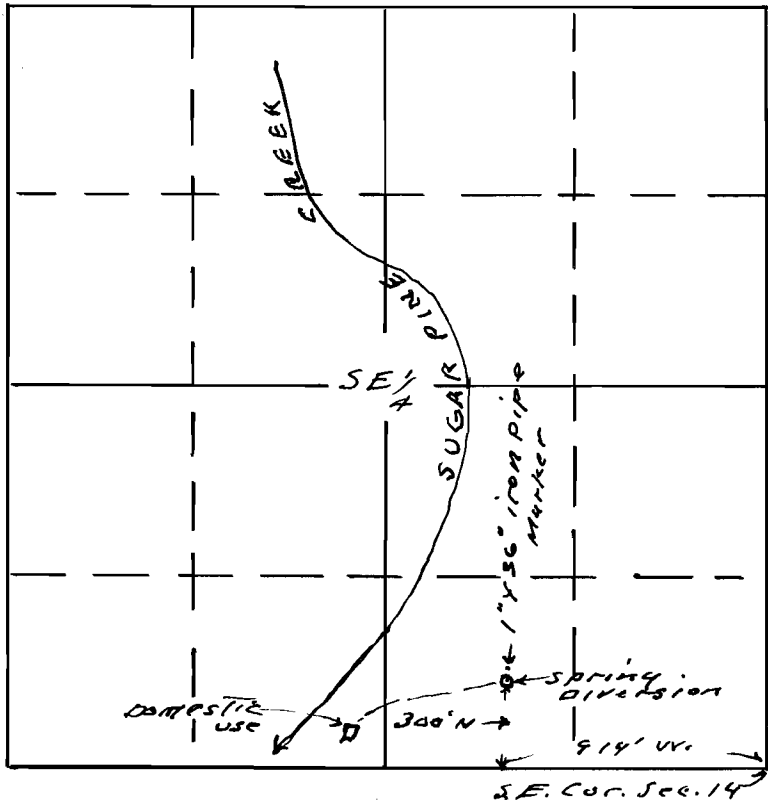

Map To accompany application
of Kenneth P. Lacy for use of
spring for domestic & garden.

This office 4/18/51 *[Signature]* W.M.

Application No. 25831
Permit No. 3222