


12-8-4  
 Joseph H. Schulte  
 P.O. Box 57 Tigard Oregon  
 File No 25838

# AMENDED PLAT OF NORTH TIGARDVILLE ADDITION

IN  
 John L. Hicklin D.L.C.  
 No. 54 T 1 S. R. 1 W and No. 37 T. 2 S. R. 1 W. Will. Mer.

Scale 1-Inch = 3 Chains

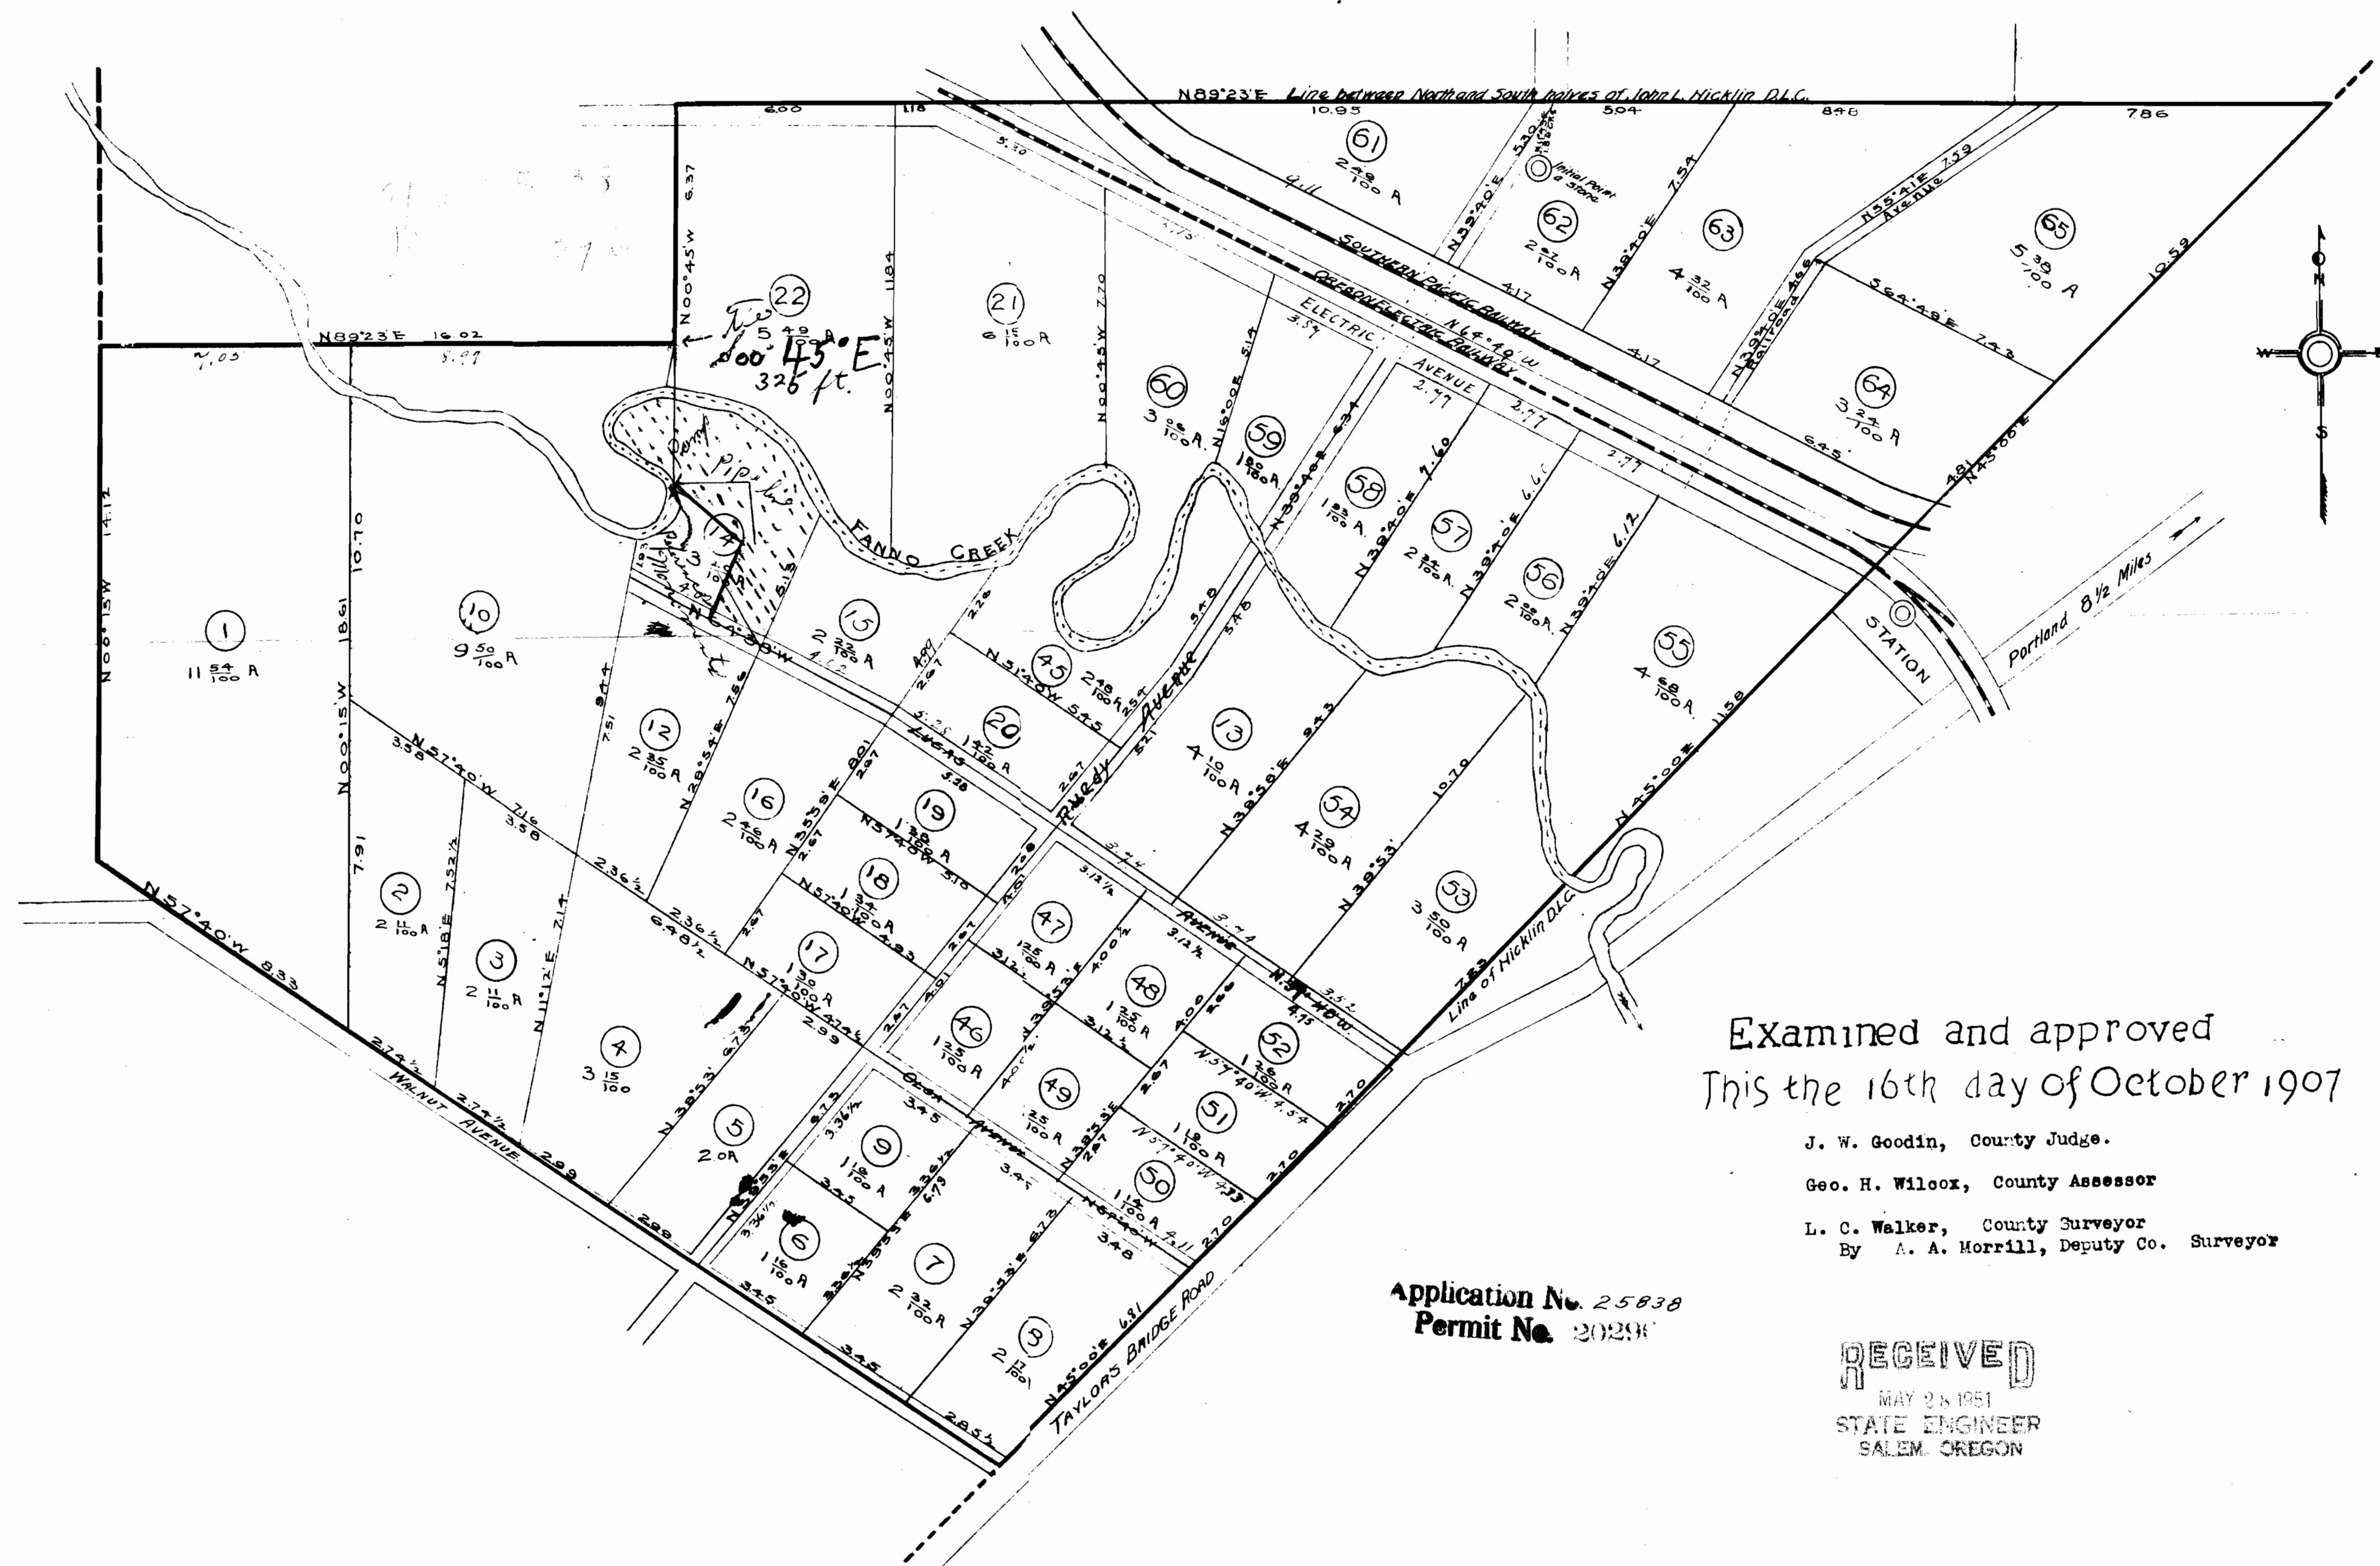

Examined and approved  
 This the 16th day of October 1907

J. W. Goodin, County Judge.  
 Geo. H. Wilcox, County Assessor  
 L. C. Walker, County Surveyor  
 By A. A. Morrill, Deputy Co. Surveyor

Application No. 25838  
 Permit No. 20296

**RECEIVED**  
 MAY 26 1951  
 STATE ENGINEER  
 SALEM, OREGON