

(Do Not Send Out of State Engineer's Office)

Instrument No. 26180
Serial No. 20431

STATE OF OREGON,)
County of Benton,) ss.
I hereby certify that the within instrument
was received for record

OAK CREEK ACRES

BENTON COUNTY, OREGON


JAMES A. BENNETT D.L.C. 45, SEC. 3, T. 12 S., R. 5 W.

1946 Jun 25 AM 9 29

and recorded in book
4 on page 44 Record of
Plate of said County.
Witness my hand and seal of County affixed.

A. J. MOORE,
County Clerk.

By A. J. Moore
Deputy.

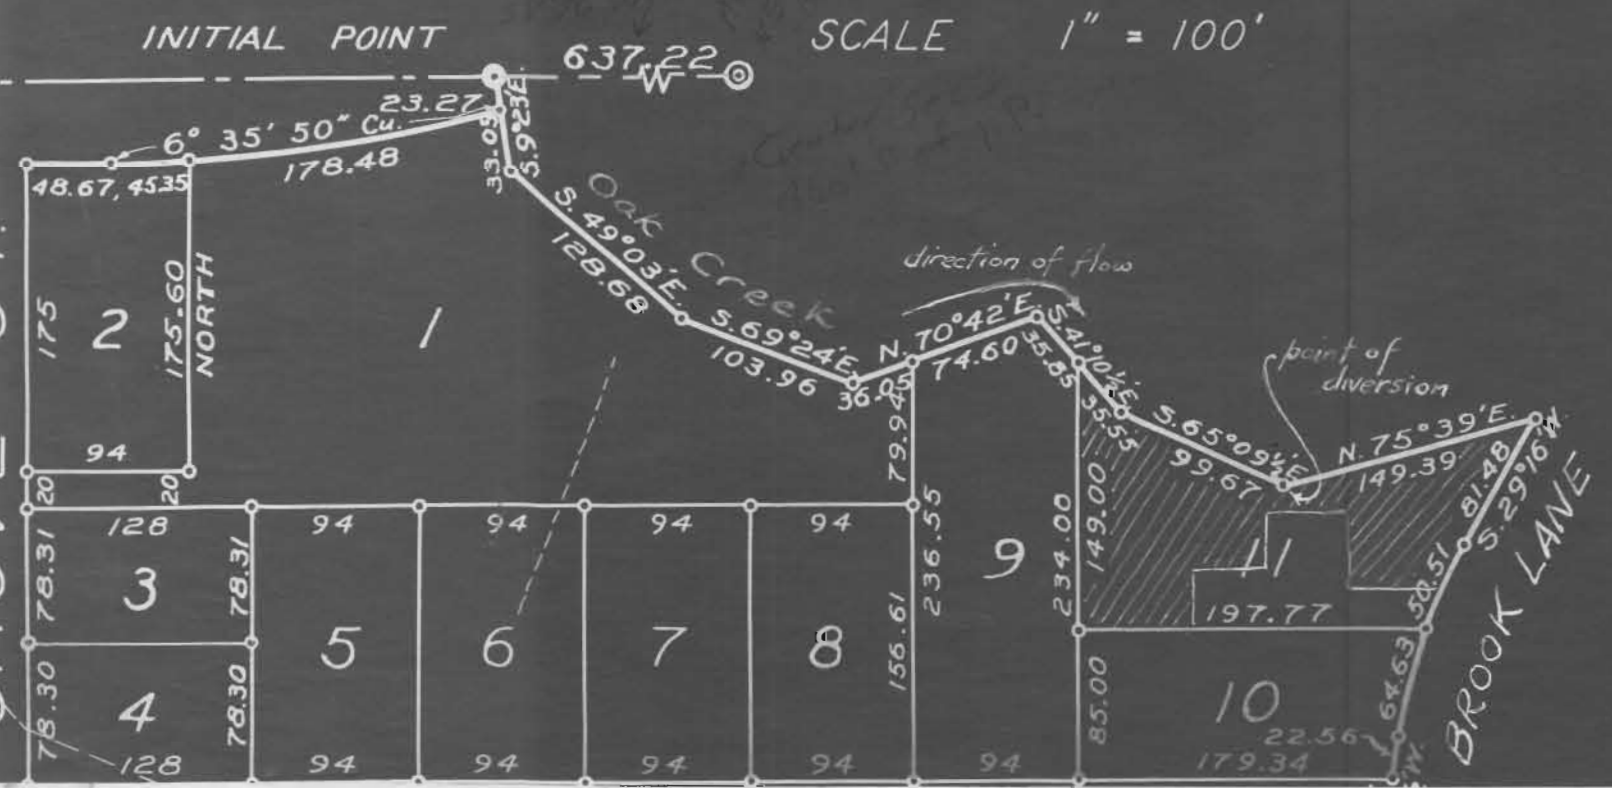

KNOW ALL MEN BY THESE PRESENTS that we, Milo A. Pratt and Anna Pratt, his proprietors and owners of the lands described in the Surveyor's affidavit hereon written and shown on the plat of "OAK CREEK ACRES" hereon placed hereby plat and lay out said parcel of land into blocks, lots and streets, the dimensions of which are in feet as shown on said plat of Oak Creek Acres. Said blocks are numbered from 1 to 3 and the lots are numbered and the streets named as shown on said plat.

That we dedicate to the use of the public without reservation or restriction the streets shown on said plat.

IN WITNESS WHEREOF, Milo A. Pratt and Anna Pratt do hereby set our hands and seals this 25th day of June, A.D. 1946

Milo A. Pratt Anna Pratt

Executed in the presence of:
Harry Loggan [Signature]
Witness

26180

JAMES A. BENNETT D. L. C. 45, SEC. 3, T. 12

