


SEC. 22-23, T. 37S., R. 1 W. W. M.

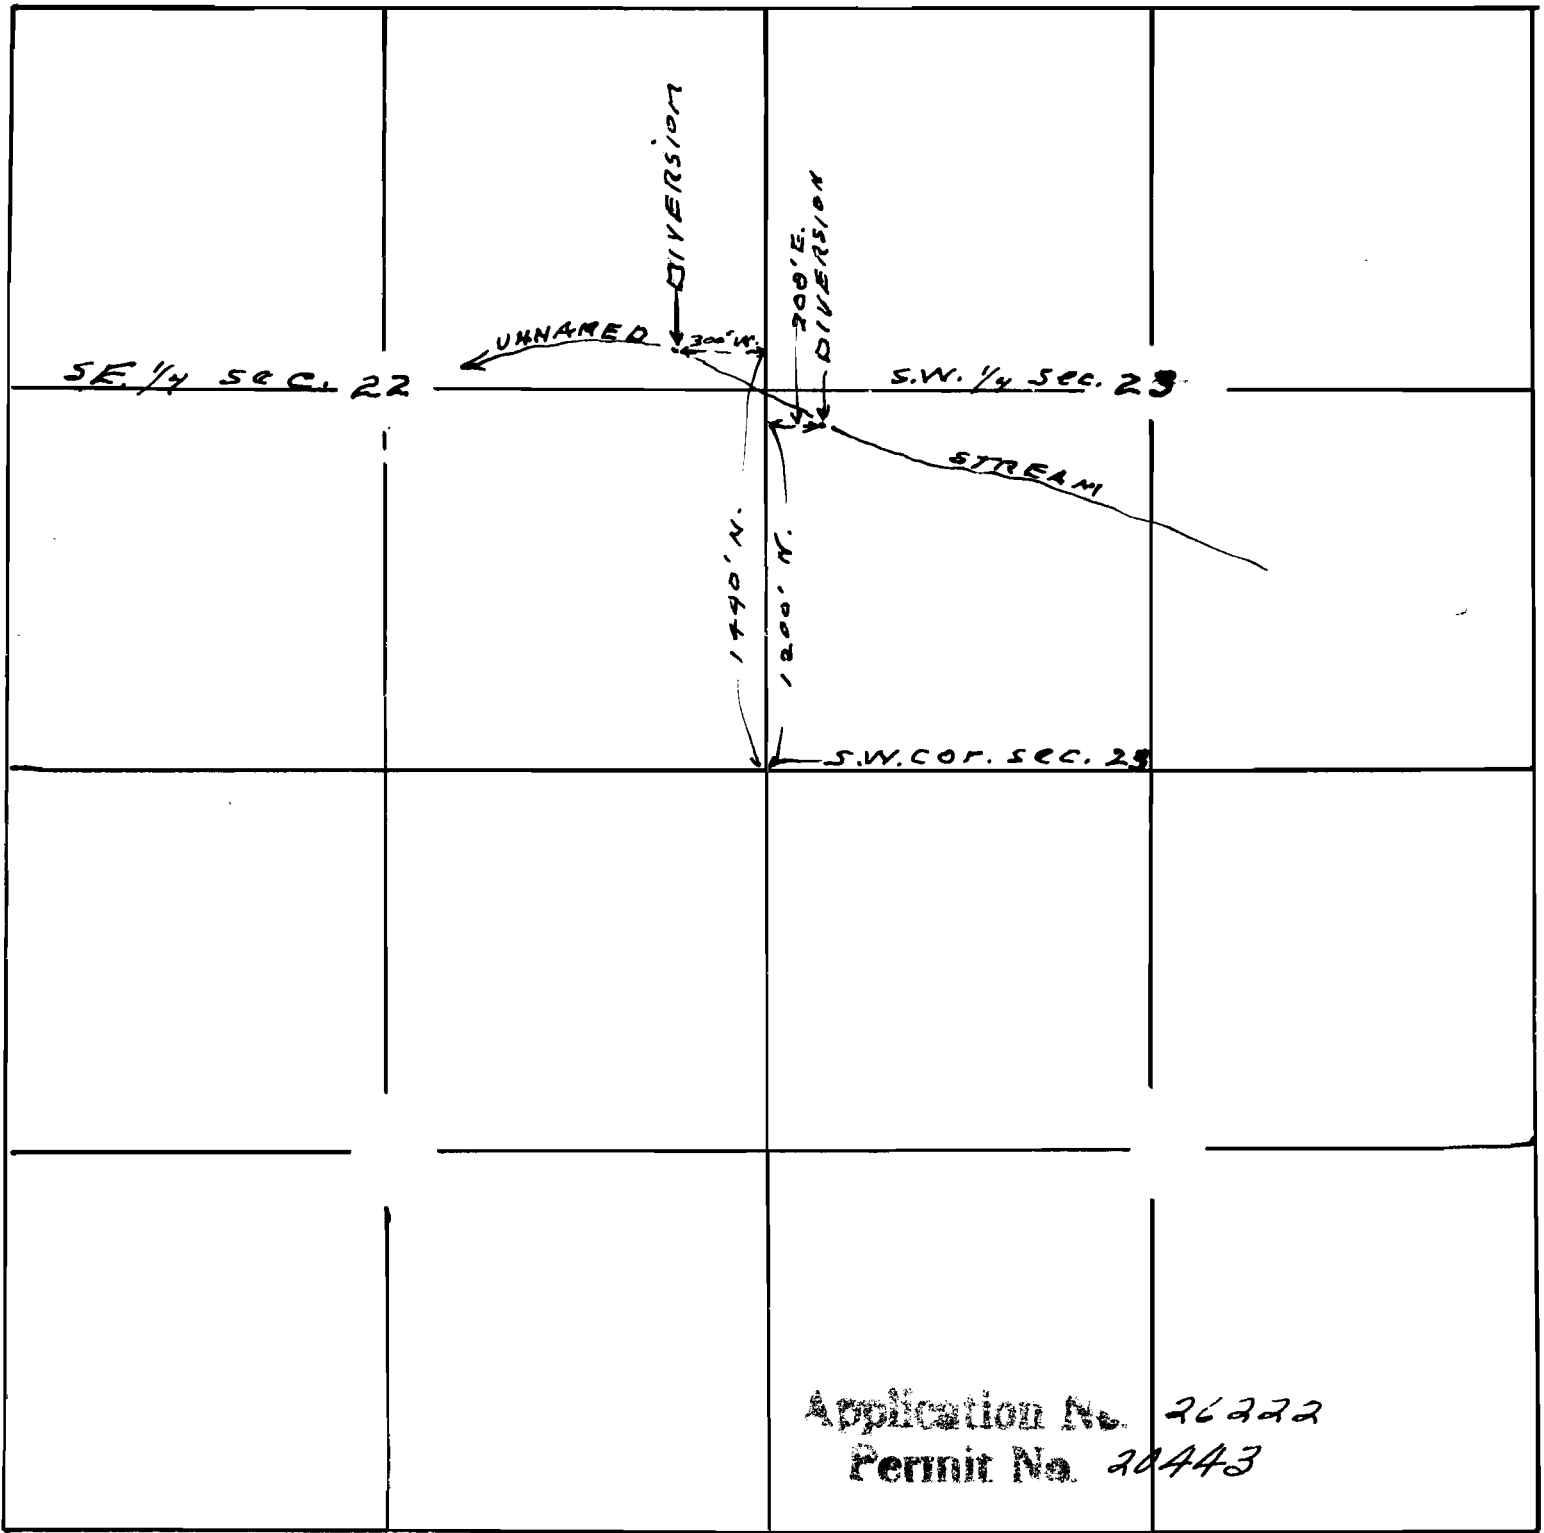

Map to accompany application of
H. E. Conger for use of water from
Unnamed stream for stock.

This office 7/19/51 *W. Smith*