

Township 3 South Range 3 West.

make over

RECEIVED

JUN 5 1951
STATE ENGINEER
SALEM, OREGON

Part of cheholm orchard Home
Subdivision. Being in sections
26, 27, 34, 35.


The Initial point being 21.12 chains
East and 11.51 chains south of
secs. 26, 27, 34, 35 T3 S R3 W

Plot Filed and Recorded in
Book 1 of plats page 59 of
yamhill County, Oregon.

section line.

Application No. 25786
Permit No. 20522

sec. 34

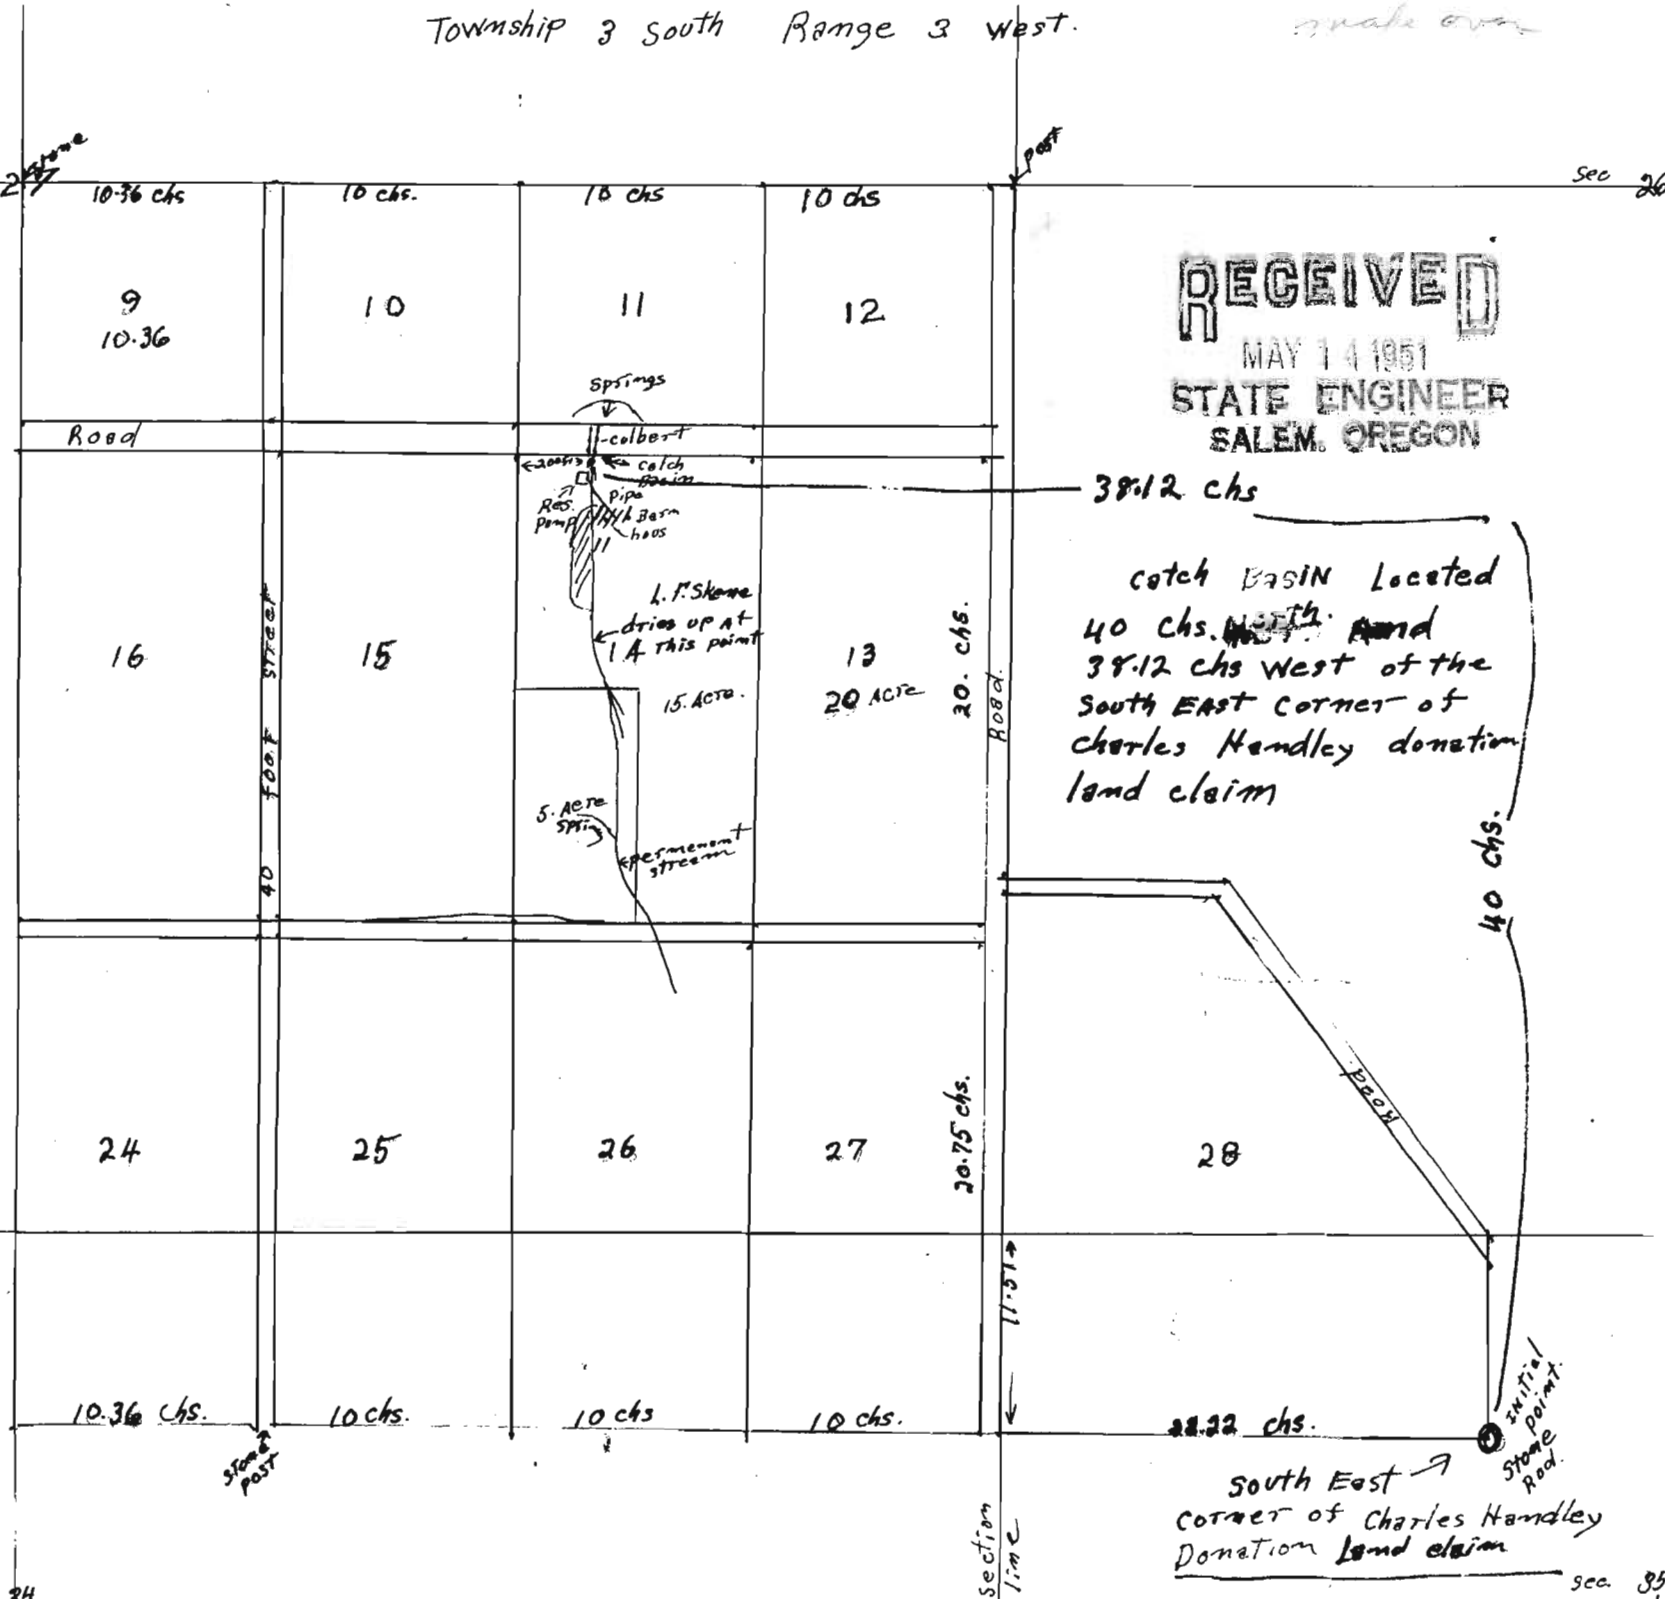

RECEIVED

MAY 14 1951
STATE ENGINEER
SALEM, OREGON

38.12 chs

catch BASIN Located
40 chs. ~~North~~ and
38.12 chs West of the
South East corner of
Charles Handley donation
land claim

40 chs.

21.12 chs.

South East →
corner of Charles Handley
Donation land claim

sec. 35