


13 18  
24 19

Plat of  
Donald R Cook's 4.5 Acres  
in David Ramsey D.L.C. in Sec. 24:T35:R3W:W.M.  
compiled from Yamhill County Assessors Records  
By M.H.Kraft -N- Tax lot #2433-10-1

Scale 1" = 400'

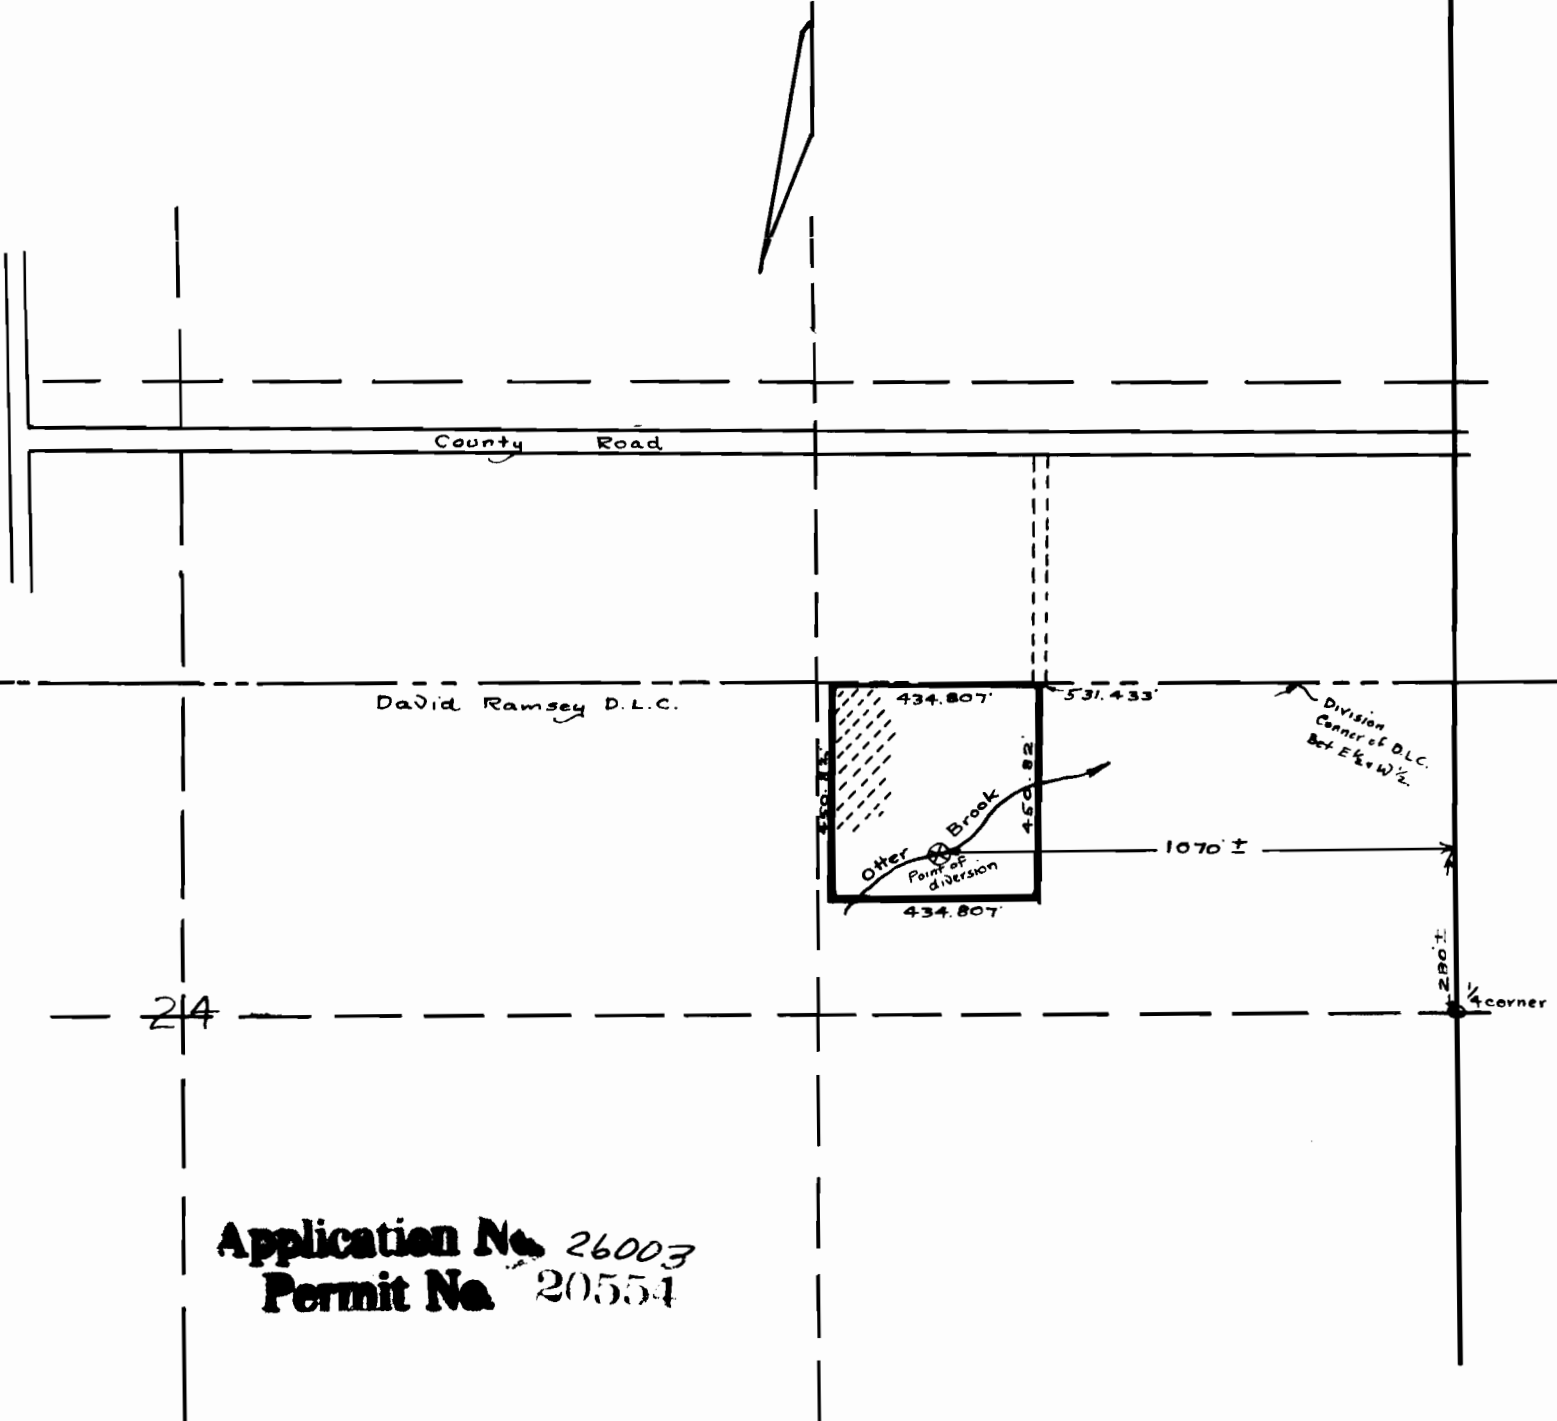

Application No. 26003  
Permit No. 20554