


# T.9S.R.45E.W.M.

*new 10/23/05*

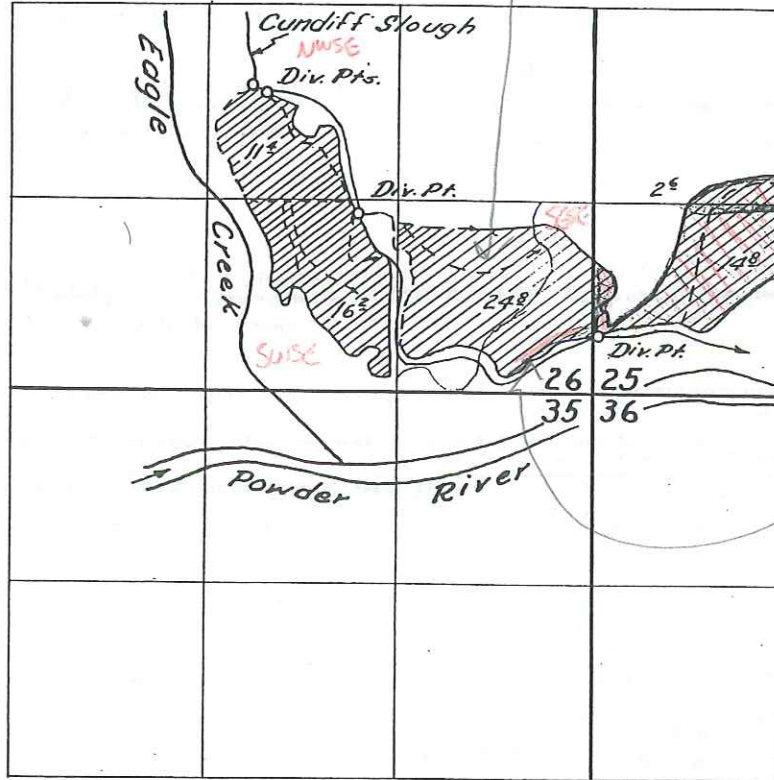

## FINAL PROOF SURVEY UNDER

Application No. 26078... Permit No. 20570...  
IN NAME OF

.....*Clavis P. Soss*.....

Surveyed *June 2* 1956., by *M. Bish*.....

BBB-9N-72