


SEC. 11, T. 36 S., R. 3 W. W. M.

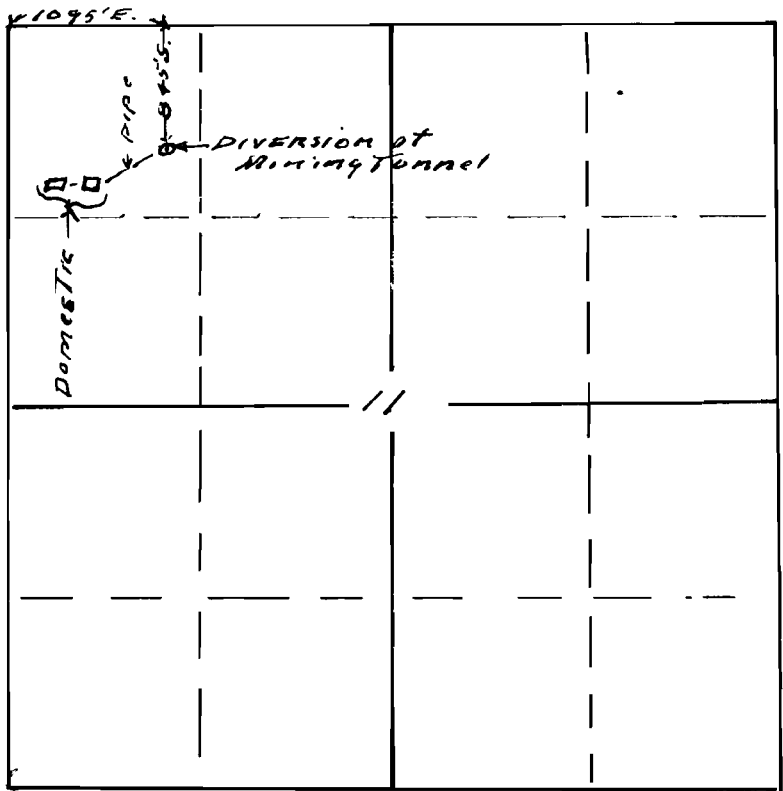

Map to accompany application of John Bocharly for use of water from Mining Tunnel for domestic purposes.

This office 8/21/51 *[Signature]*

Application No. 26349
Permit No. 20672

RECEIVED
AUG 22 1951
26349