


T.26S. R.6 W., W.M.

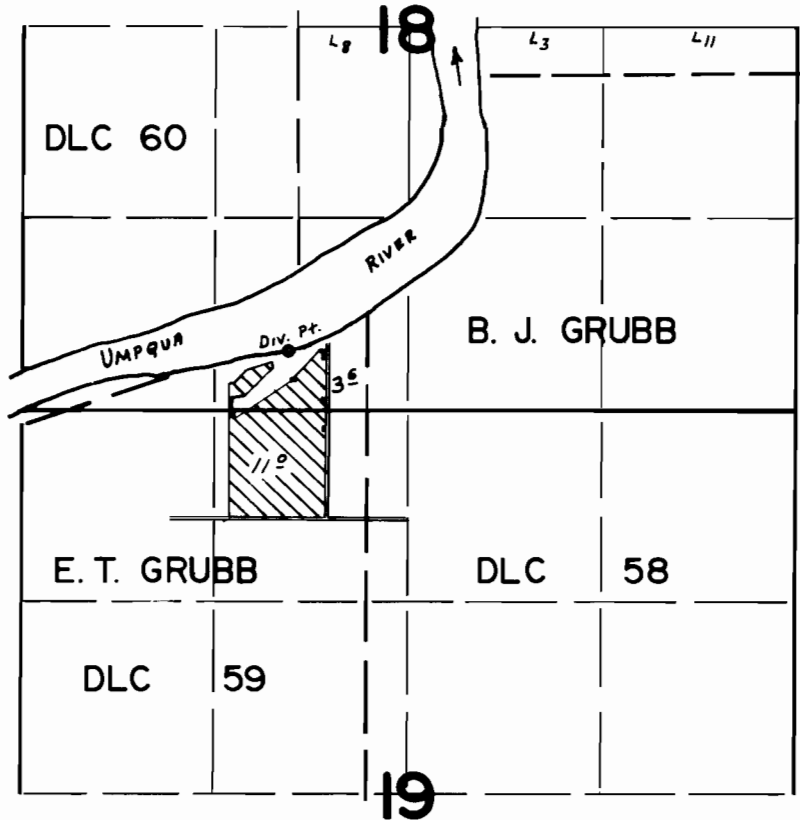

Div. Pt. Loc. 400' N. & 1820' E. FROM S. W. COR. SEC 18

FINAL PROOF SURVEY UNDER

Application No. 26354.. Permit No. 20675.....
IN NAME OF

..... LOIS & HARRY WESLEY

Surveyed JUNE..9... 1956., by C.O. BARTELS.....