


T. 36 S. R. 7 W. W. M.
scale 4" = 1 mile
Aug. 1951

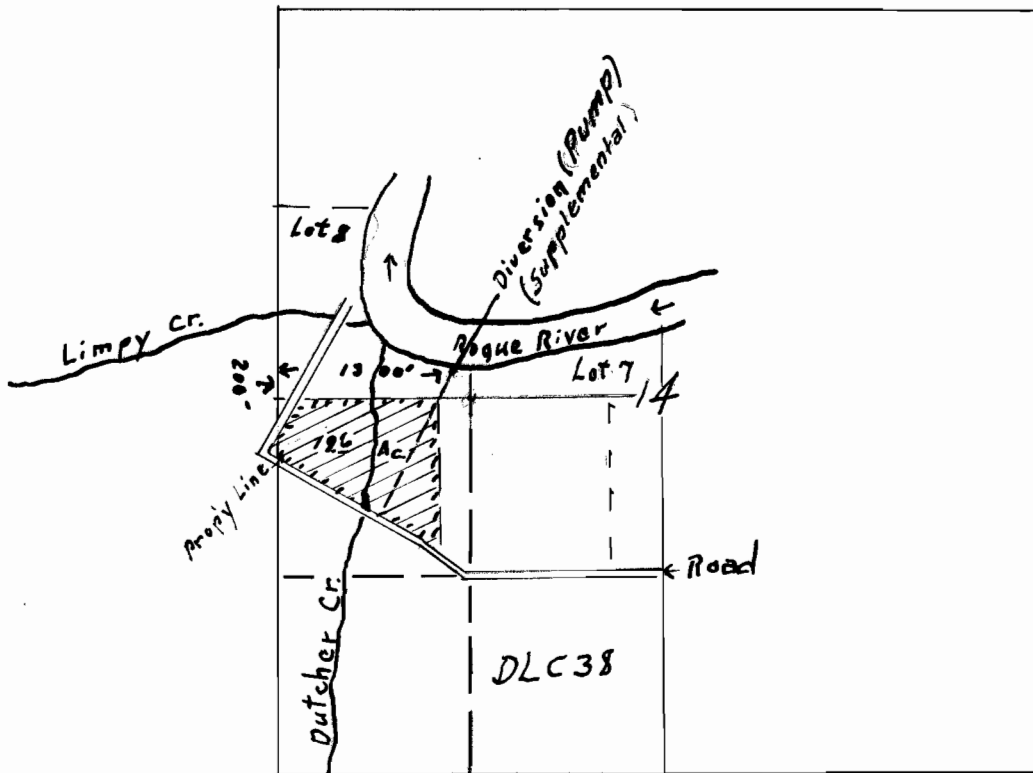

George King

Application No. 26358
Permit No. 20679

RECEIVED
AUG 27 1951
STATE ENGINEER
SALEM, OREGON

26358